

Grant


KANSAS


Form 51-5M 5-37 Petrol

Section 7 Township 29 Range 36-W

Well No. 1 Addie Bass

Company Columbian Fuel

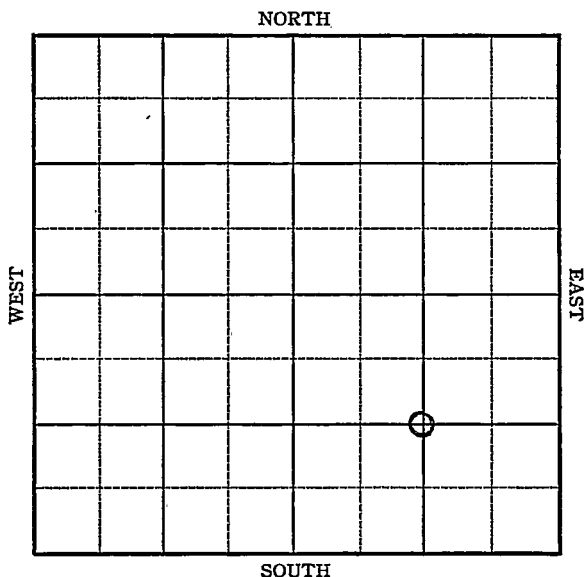

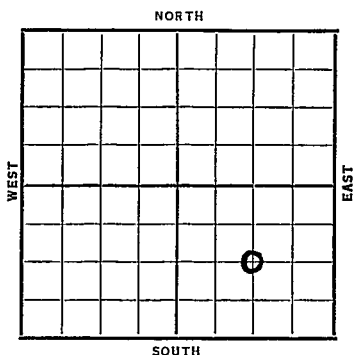Sec. 7 Twp. 29 R. 36-WWell No. #1 Addie Bass FarmColumbian Fuel Company Ft. from N. Line1320 Ft. from S. Line1320 Ft. from E. Line Ft. from W. LineElev. 3047

Date

REPORT

1937

10/13

7ⁿ - 2542'

TD 2723'

3½ M gas

Shot 310 quarts.

Pöten. 12 M gas

FIRST REPORT

and

COMPLETED

Grant **KANSAS**Map No. _____ Sec. 7 Twp. 29 R. 36WWell No. 1 Addie Bass_____ Columbian Fuel _____ Company

_____ Contractor

FIRST REPORT**C SE COMPLETED****SECTION PLAT**

_____ Ft. from N. Line

1320 Ft. from S. Line1320 Ft. from E. Line

_____ Ft. from W. Line

Location _____

Rig up _____

Drilling and Remarks:

7"-2542TD-27233 $\frac{1}{4}$ M gasShot 310 quartsPoten. 12M gas**RECORD**Cased 3 in., _____ ft.

Sand _____

Gas _____

Oil _____

Total Depth _____

PRODUCTION

1st 24 hrs. Nat. _____

1st 24 hrs. after shot _____

Gas _____ Cu. Ft.

☒ Dry Hole _____

Abandoned _____

Date

H. D. Hatfield

Scout

OCT 13 1937