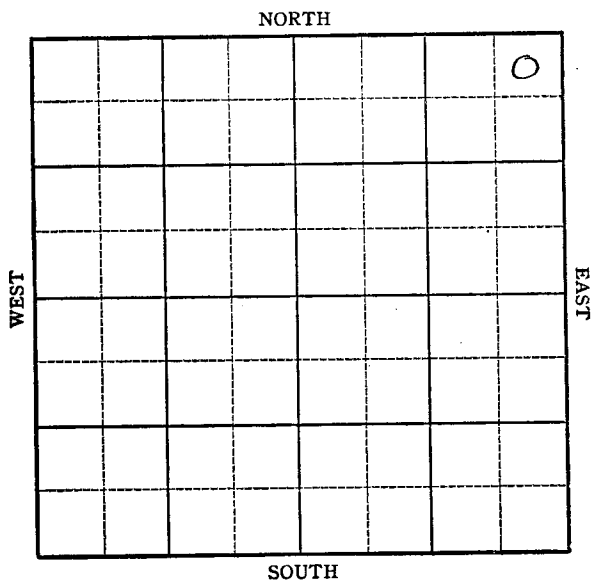


Section 8 Township 29 Range 2WWell No. 1 KimbelCompany Aladdin Pet.

Sec. 8 Twp. 29 R. 2-W

Well No. #1 Kimbel Farm

Aladdin Pet Company

Wildcat


330 Ft. from N. Line

 Ft. from S. Line

330 Ft. from E. Line

 Ft. from W. Line

NE/C

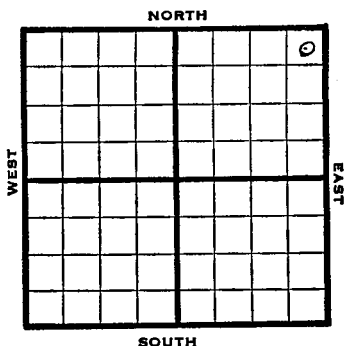

1948	REPORT
8/4	Eli 1354' Location
8/11	"
8/18	"
8/25	"
9/1	Surface hole
9/8	8" @ 135' Drlg. 1955'
9/14	KC 2014' Drlg. 3425'
9/21	Mississippi 3670' Drlg. 4180'
9/29	TD 4225' Arb. 4208'
	Aband.
	ABANDONED


Map No. 38 Sec. 8 Twp. 29 R. 2WWell No. 1 KimbelAladdin Pet.

Company

ABANDONED

Contractor

NE/C

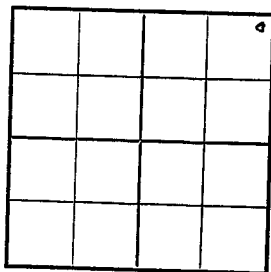E11354
SECTION PLAT330 Ft. from N. Line Ft. from S. Line330 Ft. from E. Line Ft. from W. LineSedgwick CountyLocation Rig up

Drilling and Remarks:

CRY 4208

RECORD

Cased in., ft.Sand Gas Oil Total Depth 4225

PRODUCTION

1st 24 hrs. Nat. 1st 24 hrs. after shot Gas Cu. Ft.Dry Hole Abandoned

Date

SEP 29 194819S. J. LEWISScout