


Section 8 Township 29
28 Range 32W
Well No. #1 Gatterman
Company Walter Kuhn
Hugoton Pool

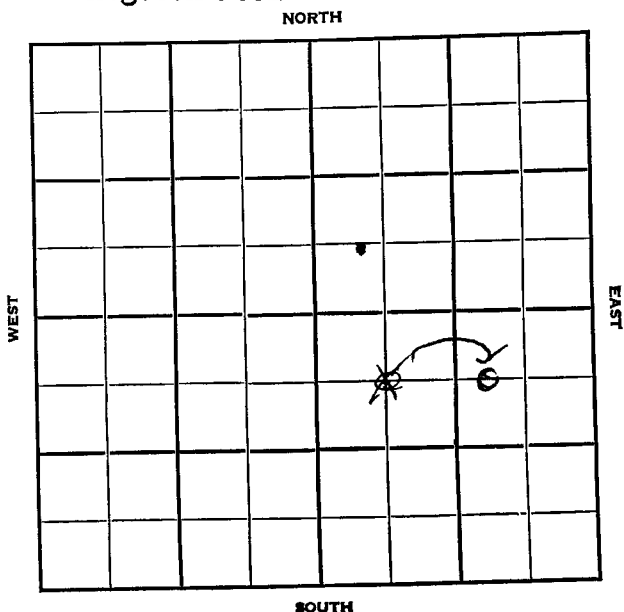

Sec. 8 Twp. 29 R. 32W

Well No. #1 Gatterman Farm

Walter Kuhn Company

Hugoton

660 Ft. from N. Line


 Ft. from S. Line

990' Ft. from E. Line

660 Ft. from W. Line

CWL NE SE

C NW SE

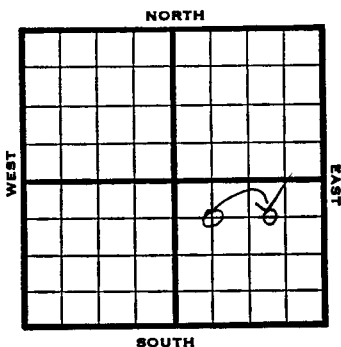

1948	Eli 2916'	REPORT	
4/14	Location		
4/21	10" @ 519' Drlg. 1700'		
4/28	SD.		
5/5	TD 2625' 7" @ 2615'		
5/12	"		
5/19	"		
5/26	"		
6/1	"		
6/9	TD 2740' 152' of 5" Perf liner 2740' 20,000 Acid		
6/16	"		
6/23	"		
6/29	"	"	
7/8	"	"	
7/14	"	"	
7/21	"	"	
7/28	"		
8/4	"		

OVER

1948

8/11

TD 2740'

152' of 5" perf liner @ 2740'

20,000 acid

8/18

"

8/25

"

9/1

"

9/8

"

9/15

7"@ 2615'

152' of 5" Perf liner @ 2740' TD

20000 acid

3,100,000 gas

405# R Pr.

Comp

COMPLETED

Map No. _____ Sec. 8 Twp. 28 R. 32E

Well No. 1 Gatterman

Walter Kuhn Company

FIRST REPORT

C NW SE Contractor

SECTION PLAT

		o	

660 Ft. from N. Line

_____ Ft. from S. Line

_____ Ft. from E. Line

660 Ft. from W. Line

Haskell County

Location X

Rig up _____

Drilling and Remarks:

RECORD

Cased _____ in., _____ ft.

Sand _____

Gas _____

Oil _____

Total Depth _____

PRODUCTION

1st 24 hrs. Nat. _____

1st 24 hrs. after shot _____

Gas _____ Cu. Ft.

Dry Hole _____

Abandoned _____

Date

APR 14 1948 19 S. J. LEWIS Scout

Map No. Sec. 8 Twp. 29 R. 32W

Well No. 1 Gatterman

Walter Kuhn

Company

CORRECTION

Contractor

C NW SE


SECTION PLAT

660 Ft. from N. Line

 Ft. from S. Line

 Ft. from E. Line

660 Ft. from W. Line

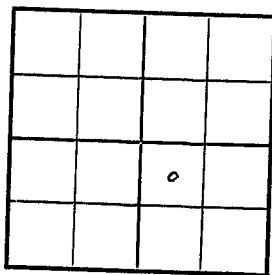

Haskell County

Location

Rig up

Drilling and Remarks:

Reported

8-28-32W

RECORD

Cased in., ft.

Sand

Gas

Oil

Total Depth

PRODUCTION

1st 24 hrs. Nat.

1st 24 hrs. after shot

Gas Cu. Ft.

Dry Hole

Abandoned

Date

APR 21 1948

19

S. J. LEWIS

Scout

Map No. _____ Sec. 8 Twp. 29 R. 32W

Well No. 1 Gatterman

Walter Kuhn

Company

CORRECTION

Contractor

C W L NE SE

SECTION PLAT

			o

660 Ft. from N. Line

 Ft. from S. Line

990 Ft. from E. Line

 Ft. from W. Line

Haskell County

Location _____

Rig up _____

Drilling and Remarks:

Reported

C NW SE

RECORD

Cased _____ in., _____ ft.

Sand _____

Gas _____

Oil _____

Total Depth _____

PRODUCTION

1st 24 hrs. Nat. _____

1st 24 hrs. after shot _____

Gas _____ Cu. Ft.

Dry Hole _____

Abandoned _____

Date

MAY 26 1948

19

S. J. LEWIS

Scout

Haskell County Kansas State

Map No. _____ Sec. 8 Twp. 29 R. 32W


Well No. 1 Gatterman

Walter Kuhn Company

COMPLETE

C W L NE SE Contractor

E 1,2916
SECTION PLAT

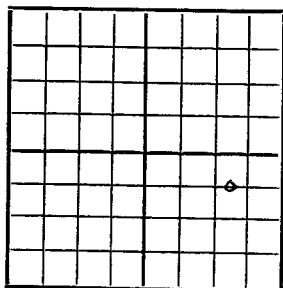

660 Ft. from N. Line

_____ Ft. from S. Line

990 Ft. from E. Line

_____ Ft. from W. Line

Hugoton Pool

Remarks:

7" @ 2610'
152' by 6" Per well @ 2740' RS
20000 acd
8,100,000 lbs
700 R/L*

Date
SEP 15 1948

Scout S. J. LEWIS