

Section 8 Township 29 Range 39W

Well No. 1 Campbell "B"

Company Stanolind

Hugoton

NORTH

				o			

WEST

EAST

SOUTH

KANSAS 29

Stanton

39W

Sec. 8

Twp.

R.

Well No. #1 Campbell "B" Farm

Stanolind Company

Hugoton

Ft. from N. Line

100


Ft. from S. Line

Ft. from E. Line

100

Ft. from W. Line

Hugoton

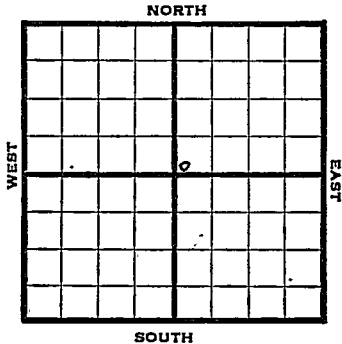

1947

Elev. 3225' REPORT

10/22

Location

10/29

"

11/5

10" @ 626'
Drlg. 1880'

11/12

TD 2315'
7" @ 2311'
RUST

11/19

TD 2530 '
240' of 5" Perf liner @ 2830'
18,500 Acid

11/25

"

12/3

7" @ 2311'
240' of 5" Perf liner @ 2530
Acid 18,500
Gas 6 M
R. Pr. 410#
Total Depth 2530'

COMPLETED

Map No. _____ Sec. 8 Twp. 29 R. 39W

Well No. 1 Campbell "B"

Stanolind Company

FIRST REPORT Contractor

SW NE

SECTION PLAT

_____ Ft. from N. Line

100 Ft. from S. Line

_____ Ft. from E. Line

100 Ft. from W. Line

		o	

Stanton County

Location X

Rig up _____

Drilling and Remarks:

RECORD

Cased _____ in., _____ ft.

Sand _____

Gas _____

Oil _____

Total Depth _____

PRODUCTION

1st 24 hrs. Nat. _____

1st 24 hrs. after shot _____

Gas _____ Cu. Ft.

Dry Hole _____

Abandoned _____

Date

OCT 22 1947 19 _____ S. J. LEWIS Scout

Map No. _____ Sec. 8 Twp. 29 R. 39W

Well No. 1 Campbell "B"

Stanolind Company

COMPLETE Contractor

SW NE

E13225

SECTION PLAT

_____ Ft. from N. Line

100 Ft. from S. Line

_____ Ft. from E. Line

100 Ft. from W. Line

		0	

Stanton County

Location _____

Rig up _____

Drilling and Remarks:

7" @ 2311
240' of 5" Perf liner
@ 2530
18,500 cu. ft.
6M Gas

410 # R/A

RECORD

Cased _____ in., _____ ft.

Sand _____

Gas _____

Oil _____

Total Depth 2530

PRODUCTION

1st 24 hrs. Nat. _____

1st 24 hrs. after shot _____

Gas _____ Cu. Ft.

Dry Hole _____

Abandoned _____

Date

DEC 3 1947 19

S. J. LEWIS Scout