

KANSAS


Haskell

~~Highton~~

Section 8 Township 29 Range 34W

Well No. #2 ~~#1~~ Collingwood

Company United Prod

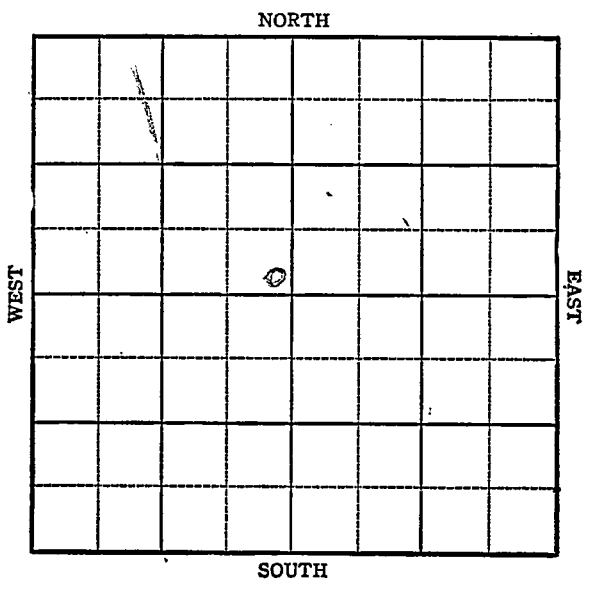

KANSAS

Haskell

Sec. 8 Twp. 29 R. 34W

Well No. #2 #1 Collingwood Farm

United Prod Company

Hugoton


NORTH

_____ Ft. from N. Line

100 _____ Ft. from S. Line

100 _____ Ft. from E. Line

_____ Ft. from W. Line

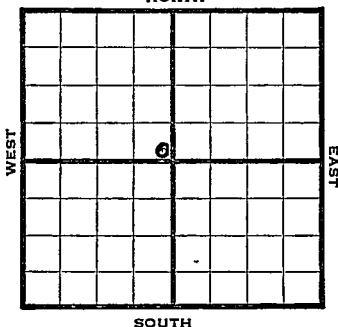

Elev 3004

1944

REPORT

7/26	Location
8/2	600 fsg.
8/9	10" @ 682
	Drlg. 1960
8/16	7" @ 2558 RUST
8/23	TD 2742 1/10 M Gas
8/30	" " " " "
9/8	8000 acid
9/13	Sand 2475'
	7" @ 2558'
	8000 acid.
	TD 2742'
	10 Mile gas.

COMPLETED

Pool Name Hugoton

Map No. ~~KANSAS~~ Sec. 8 Twp. 29 R. 34 W

Well No. 1 Collingwood

United Prod. Company

FIRST REPORT Contractor

SE NW

SECTION PLAT

 Ft. from N. Line

100 Ft. from S. Line

100 Ft. from E. Line

 Ft. from W. Line

Haskell County

Location X

Rig up

Drilling and Remarks:

RECORD

Cased in., ft.

Sand

Gas

Oil

Total Depth

PRODUCTION

1st 24 hrs. Nat.

1st 24 hrs. after shot

Gas Cu. Ft.

Dry Hole

Abandoned

Date

JUL 2 6 1944 19

S. J. LEWIS Scout

KANSAS

Pool Name HugotonMap No. N/M Sec. 8 Twp. 29 R. 34WWell No. 2 Collingwood

United Prod.

Company

CORRECTION

Contractor

SE NW

SECTION PLAT

_____ Ft. from N. Line

100 Ft. from S. Line100 Ft. from E. Line

_____ Ft. from W. Line

Haskell County

Location _____

Rig up _____

Drilling and Remarks:

Reported as
#1 Collingwood

RECORD

Cased _____ in., _____ ft.

Sand _____

Gas _____

Oil _____

Total Depth _____

PRODUCTION

1st 24 hrs. Nat. _____

1st 24 hrs. after shot _____

Gas _____ Cu. Ft.

Dry Hole _____

Abandoned _____

Date

AUG 2 1944S. J. LEWIS Scout

