


KANSAS

FORM 51 5M PETROL

Section 9 Township 29 Range 35W

Well No. 1 Alexander

Company Columbian Fuel

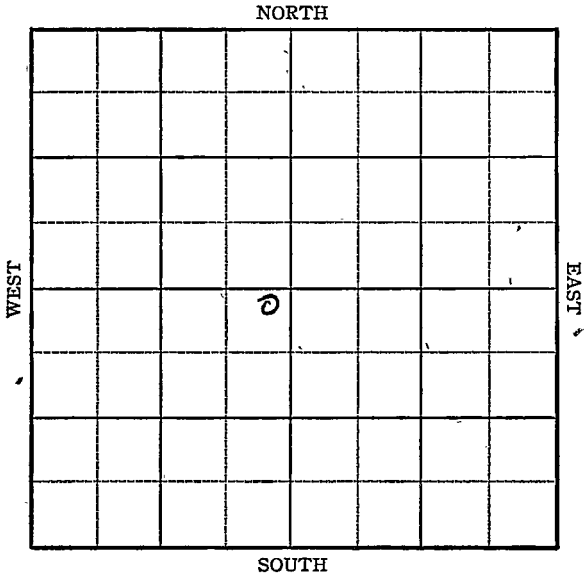

Sec. 9 Twp. ~~24~~ R. 35

Well No. 1 Alexander Farm

Columbian Fuel Company


Hugoton

100 Ft. from N. Line

Ft. from S. Line

100 Ft. from E. Line

Ft. from W. Line

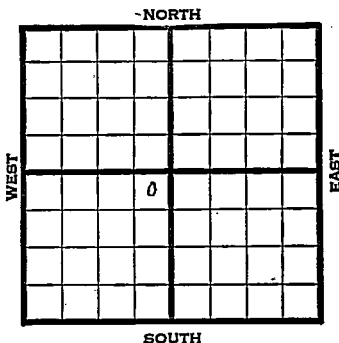

NE SW Elev. 3030

1945 REPORT

5/23	RUR			
6/8	7" @ 2517	TD 2520	RUST	
6/14	TD 2750			
	1 M Gas			
6/21	253' of 5" Perf liner @ 2750			
6/28	"	"	"	"
7/3	"	"	"	"
7/11	"	"	"	"
7/19	"	"	"	"
7/26	"	"	"	"
8/1	"	"	"	"
8/8	"	"	"	"
8/15	"	"	"	"
8/22	"	"	"	"
8/29	"	"	"	"
9/5	"	"	"	"
9/12	"	"	"	"
9/19	"	"	"	"
9/26	"	"	"	"
10/3	"	"	"	"
10/10	"	"	"	"
10/17	"	"	"	"
10/24	"	"	"	"
10/31	"	"	"	"
11/7	"	"	"	"
11/14	"	"	"	"
11/21	"	"	"	"
11/28	"	"	"	"
12/5	"	"	"	"

OVER

1945

12/12 253' of 5" perf. liner @ 2750

12/20 " " "

12/28 7" @ 2517

253' of 5" Perf. liner @ 2750

14,000 acid.

TD 2750

13,200,000 Gas.

418# R Pr.

COMPLETED

62

Kansas Pool Name HugotonMap No. _____ Sec. 9 Twp. 24 R. 35WWell No. 1 AlexanderColumbian Fuel Company

FIRST REPORT

Contractor

NE SW

SECTION PLAT

100 Ft. from N. Line

_____ Ft. from S. Line

100 Ft. from E. Line

_____ Ft. from W. Line

	o		

Grant

RECORD

Location _____

Cased _____ in., _____ ft.

Rig up _____

Sand _____

Drilling and Remarks:

Gas _____

RUR

Oil _____

Total Depth _____

PRODUCTION

1st 24 hrs. Nat. _____

1st 24 hrs. after shot _____

Gas _____ Cu. Ft.

Dry Hole _____

Abandoned _____

Date

MAY 23 1945 19

S. J. LEWIS Scout

check this well
Twp- Range put it
in Kearney County
Advise
Sam

check the County
don't believe in Grant
County
no
Sam

Small Maps	
Cards	<i>[Signature]</i>
Tracing	
France Map	<i>[X]</i>
Scarborough Map	<i>[X]</i>
Pierce Map	
Geological Dept.	
Pierce Plat Book	

Kansas Pool Name HugotonMap No. no map Sec. 9 Twp. 29 R. 35WWell No. 1 AlexanderColumbian Fuel CompanyCORRECTION Contractor

NE SW

SECTION PLAT

100 Ft. from N. Line

_____ Ft. from S. Line

100 Ft. from E. Line

_____ Ft. from W. Line

Grant

Location _____

Rig up _____

Drilling and Remarks:

reported9-24-35W

RECORD

Cased _____ in., _____ ft.

Sand _____

Gas _____

Oil _____

Total Depth _____

PRODUCTION

1st 24 hrs. Nat. _____

1st 24 hrs. after shot _____

Gas _____ Cu. Ft.

Dry Hole _____

Abandoned _____

Date

MAY 29 1945 19S. J. LEWIS

Scout

6/11/45

check
County
Advise
Sam

Misc. Small Maps	_____
Cards	_____ <i>[Signature]</i>
Tracing	_____
France Map	_____
Scarborough Map	_____ <i>[Signature]</i>
Pierce Map	_____
Geological Dept.	_____
Pierce Plat Book	_____

This is correct

Candy

KANSAS

Kansas Pool Name Hugoton

Map No. 2 1/2 Map Sec. 9 Twp. 29 R. 35W

Well No. 1 Alexander

Columbian Fuel Company

COMPLETED

Contractor

E. J. 3086

NE SW

SECTION PLAT

100 Ft. from N. Line

 Ft. from S. Line

100 Ft. from E. Line

 Ft. from W. Line

Grant County

Location

Rig up

Drilling and Remarks:

*2" C 2517
258' 1/2" Perf liner
C 2750
14,000 acid
18,200,000 Gas
418 # R Br*

RECORD

Cased in., ft.

Sand

Gas

Oil

Total Depth 2750

PRODUCTION

1st 24 hrs. Nat.

1st 24 hrs. after shot

Gas Cu. Ft.

Dry Hole

Abandoned

Date

DEC 2 8 1945 19

S. J. LEWIS Scout

125247

no

Misc. Small Maps	<i>OK</i>
Cards	<i>Barack</i>
Tracing	<i>✓</i>
France Map	<i>✓</i>
Scarborough Map	<i>✓</i>
Pierce Map	<i>✓</i>
Geological Dept.	
Pierce Post Book	