


Section 34 Township 2 Range 11 W


Well No. # 1 McCall HABIGER

Company Chas. L. Lasky (Lubbock, Texas)

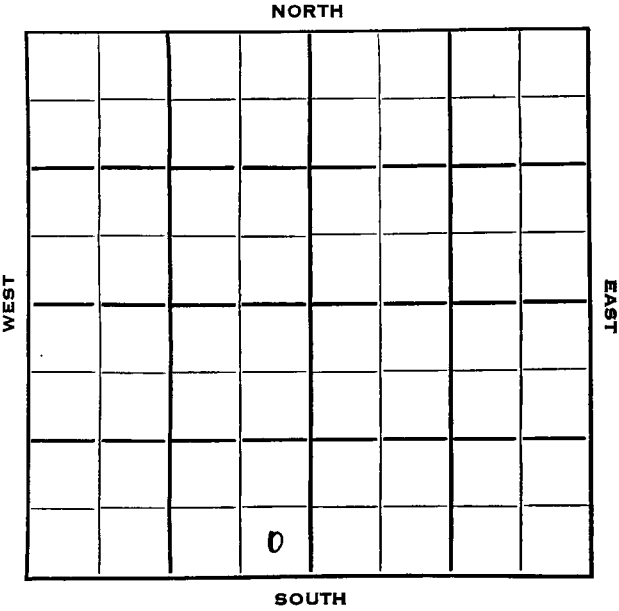

14

County Smith State Kansas
 Sec. 34 (Blk. 2) (Sur. 11W) (Rge. Map No.)
 Operator Chas. L. Lasky (Lubbock, Texas)
 Well No. 1 Farm Habiger
 Elev. SE SE SW Location

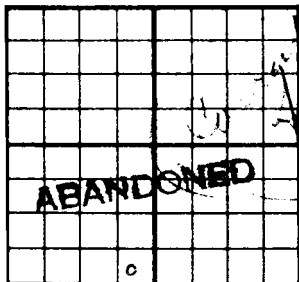

330 Ft. From S Line SW
330 Ft. From E Line Quarter
1st. Report

Completion MAY 26 1954

Remarks Wildcat

Knights - Contr.

Spudding Date 5-1-54

Orig. Data D & A TD 4250

8" C 217 Top. 2672 Lans. 2954

DST 3165-36 open 1 hr. Rec. 95' mud

600' sw 1195' Miss. 3705 DST 3705-20

open 1 hr. Rec. 755' sw 1195'

Leisner 3814 Hunton 3831 Mag. 3921

Viola 4010 Sims. 4168 Arb. 4202

TD 4250

D & A

L. G. McNEHEE

County	Smith		State	Kansas	
Sec.	34	(Blk. Twp.)	2	(Sur. Rge.)	11W Map No.
Operator	Chas. L. Lasky		(Lubbock, Texas)		
Well No.	1	Farm	McCall		
Elev.	Location		SE SE SW		

FIRST REPORT

330 Ft. From **S** Line **SW**
330 Ft. From **E** Line Quarter
1st. Report **MAY 12 1954**
Completion
Remarks
Knight - Contr.
Spudding Date **5-1-54**

Orig. Data **Wildcat**

8" @ 217 drlg. 3280

J. G. McGEHEE

Smith KANSAS

SEC.	TWP.	R.
34	2	11W ✓

WELL NO.

HABIGER
~~1 McGall~~

FARM

COMPANY

Chas. L. Lasky (Lubbock, Texas)

CONTRACTOR

Knight

Wildcat


Ft. from N. Line

Ft. from S. Line

Ft. from E. Line

Ft. from W. Line

SE SE SW

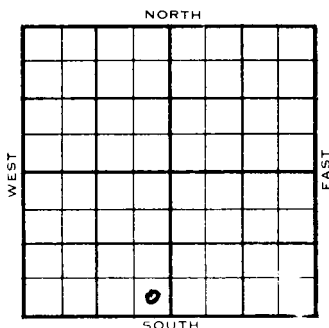

	ELEVATION	REPORT
1954	-	

5/12 Spud 5-1-54
 8" @ 217'
 Drlg. 3280'

5/19 D & A

5/26 Spud 5-1-54
 D&A
 TD 4250'
 8" @ 217'
 Top 2672', Lans 2954'
 DST 3165-86', opn 1 hr., rec. 95' mud.
 600' SW, 1195#
 Miss 3705'
 DST 3705-20', opn ~~1 1/2~~ hrs., rec
 755' SW, 1195#
 Meisner 3814', Hanton 3831', Maq. 392'
 Viola 4010', Simp. 4168', Arb. 4202'
 TD 4250'
 D&A

ABANDONED