


Smith
 Map No. **KANSAS** Sec. 4 Twp. 2 R. 13^w
 Well No. 1- Lambert Farm
Mid-Kansas O & G Company

NORTH

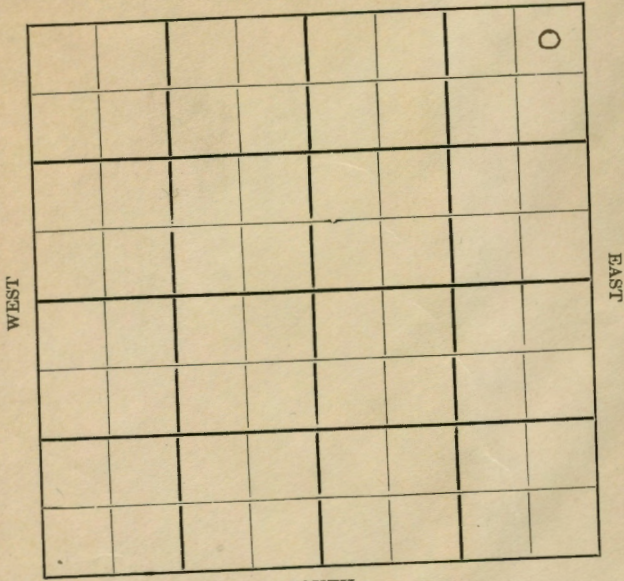

SOUTH

Location
 Drilling Remarks

Rig Up
 Drilling Remarks


RECORD
 Cased in ft.
 Sand
 Gas
 Oil
 Total Depth

PRODUCTION
 1st 24 hrs. Nat.
 1st 24 hrs. after shot
 Gas cu. ft.
 Dry Hole
 Abandoned

Map No. **KANSAS** Sec. 4 Twp. 2 R. 13^w
 Well No. 1- Lambert Farm
Mid-Kansas O & G Company

NORTH

330 Ft. from N. Line
 Ft. from S. Line
330 Ft. from E. Line
 Ft. from W. Line

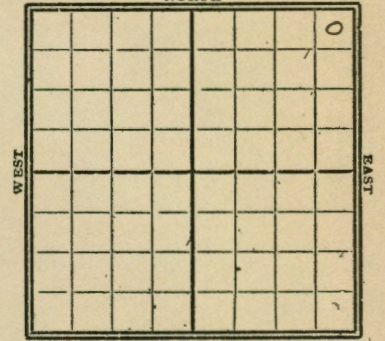

SOUTH

1928

Date	REPORT
12/5	RoG
12/12	
12/12	Rig
12/19	Spud
12/26	no report
1929	
1/2	drlg 810'
1/9	" 900'
1/16	" 1025'
1/23	" 1125'
1/30	fsg tools 1260-T.D.
2/6	
2/13	drlg 1925'
2/19	run 10"-2115'
2/27	drlg 2320'
3/6	" 2530'
3/13	VIR 8"-2725' TD. 2735'
3/20	H.F.W. 2870-78'
	VIR 8" three
3/27	Drlg 3060'
4/3	" 3225'
4/9	" 3320'

4/17 - T.D. 3485 fish tools

4/24

5/11 - fish tools 3560

5/18 -

5/15 - Wrlg 3730'

5/22 - " 3763

HFW 3759

5/29 - Wrlg 3861

6/5 - " 3946

6/12 - " 3998

6/19 - T.D. 4099'

Dry & Abandoned

Map No. **KANSAS** Sec. 4 Twp. 2 R. 13W

Well No. 1 *Lane Kelly*

Mid-Kansas O & G Company

Contractor

SECTION PLAT

			0

330 Ft. from N. Line

..... Ft. from S. Line

330 Ft. from E. Line

..... Ft. from W. Line

ABANDONED

Location.....

Rig up.....

Drilling and Remarks:

JYA

RECORD

Cased.....in.,ft.

Sand.....

Gas.....

Oil.....

Total Depth 4099

PRODUCTION

1st 24 hrs. Nat.....

1st 24 hrs. after shot.....

Gas.....Cu. Ft.

Dry Hole.....

Abandoned.....

Date

JUN 19 1929

192

S. J. LEWIS

Scout

No. 130 **KANSAS** MAP No. SEC. 4 TWP. 2 R. 13W

WELL No. 1

Mid-Kansas O & G COMPANY

CONTRACTOR

SECTION PLAT

			0

330 FT. FROM N. LINE

..... FT. FROM S. LINE

330 FT. FROM E. LINE

..... FT. FROM W. LINE

FIRST REPORTS

LOCATION.....

RIG UP.....

DRILLING AND REMARKS:

ROG

RECORD

CASED.....IN.....FT.

SAND.....

GAS.....

OIL.....

TOTAL DEPTH.....

PRODUCTION

1ST 24 HRS. NAT.....

1ST 24 HRS. AFTER SHOT.....

GAS.....Cu. Ft.

DRY HOLE.....

ABANDONED.....

DATE

DEC 5 1928

192

S. J. LEWIS

SCOUT