


Section 4 Township 2 Range 18W
Well No. #1 Folgeman
Company Honaker Drlg.

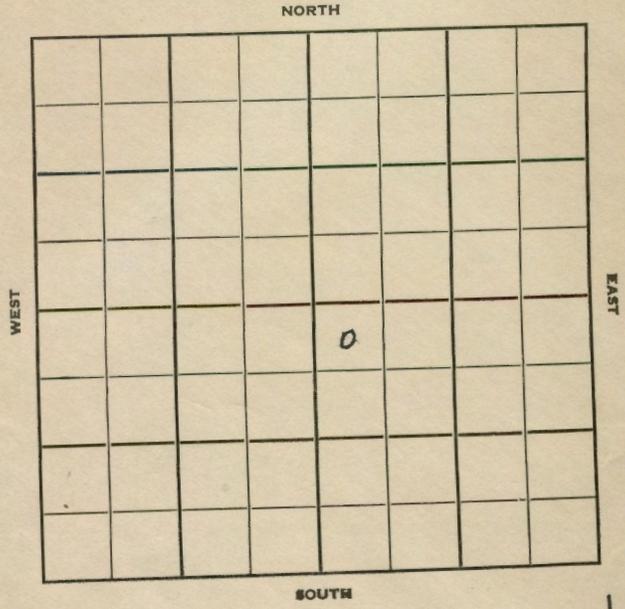


10

Sec. 4 Twp. 2 R. 18W ✓
Well No. #1 Folgeman Farm
Honaker Drlg. Company
Contractor

330' Ft. from N. Line
Ft. from S. Line
Ft. from E. Line
330' Ft. from W. Line

NW NW SE

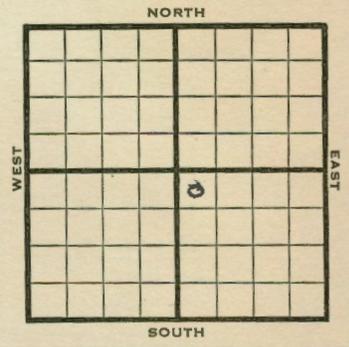

1950 **Elev 2229** REPORT

8/9 Spud 8-2-50
8-5/8" @ 250'
Anhy 1825'
Drlg. 2950'
8/16 8 5/8" @ 250
Anhy 1825
Lans 3432
TD 3555
D&A

Heeb 3406

ABANDONED

