


Section 5 Township 2 Range 18W

Well No. #1 Imm "C"

Company B & R Drlg.

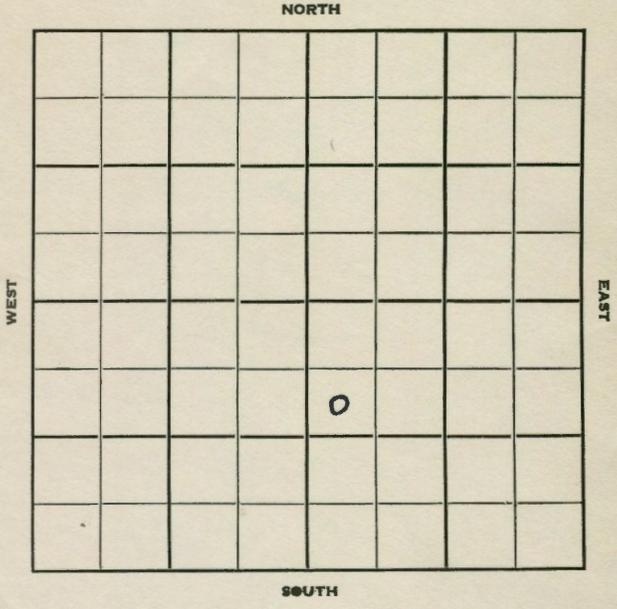

10

Sec. 5 Twp. 2 R. 18W ✓

Well No. #1 Imm "C" Farm \_\_\_\_\_

B & R Drlg. Company \_\_\_\_\_

B & R Drlg. - Contr. Contractor \_\_\_\_\_

Huffstutter Pool


990' Ft. from N. Line

\_\_\_\_\_ Ft. from S. Line

\_\_\_\_\_ Ft. from E. Line

330' Ft. from W. Line

SW NW SE

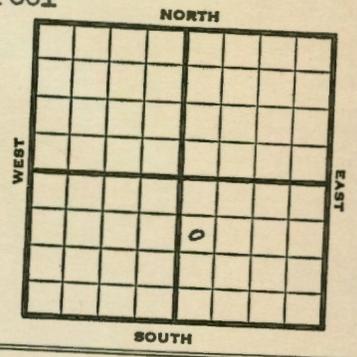

1951 **Elev. 2219'** REPORT

1/3 Spud 12-28-50  
8" @ 180  
Drlg. 2920'

2/14 Spud 12-28-50  
Oil Well TD 3485  
8" @ 180'  
**Heeb. 3340'** **Lans. 3366'**  
5" @ 3485' TD 3485  
24/3472-77 SSO  
23/3462-67 B/1½ boph 2000 A  
S/7 boph Comp. 105 bopd

**COMPLETED**

