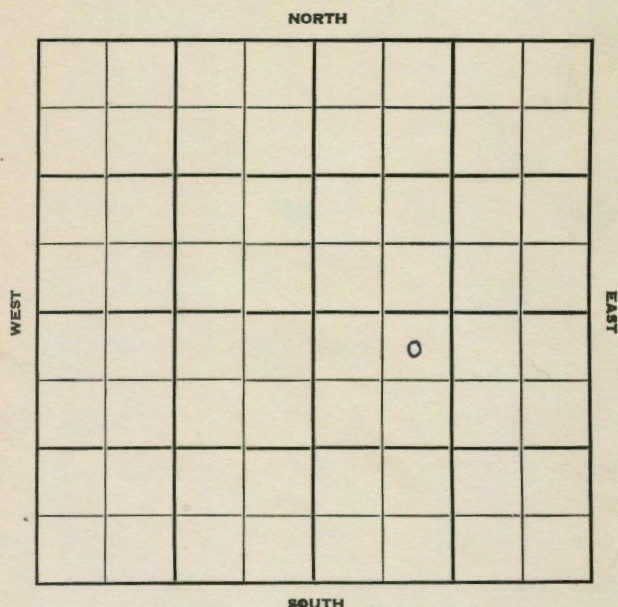


Section 5 Township 2 Range 18 WWell No. # 2 Imm "C"Company B & R Drlg. et al

10

Sec. 5 Twp. 2 R. 18WWell No. #2 Imm "C" Farm ☒B & R Drlg. et al Company

Contractor


330' Ft. from N. Line

Ft. from S. Line

Ft. from E. Line

990' Ft. from W. Line

NE NW SE

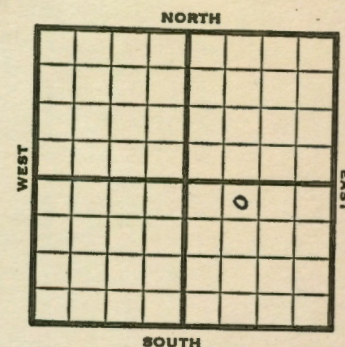1951 **Elev. 2203'** REPORT

3/28 Spud 3-25-51
8" @ 185'
WOC

5/2 Spud 3-25-51
Oil well TD 3472'
8" @ 185' Heeb 3326' KC 3353'
5" @ 3470 TD 3472' 12/3455-58
3 GW SSO 8 hr. 24/3441-48
21 GOPH 3000 A S/5½ BOPH
Comp. 83 BOPD

COMPLETED

County	Phillips			State	Kansas
Sec.	5	(Blk. Twp.)	2	(Sur. Rge.)	18W Map No.
Operator	B & R Drlg. etal.				
Well No.	2	Farm	Imm "C"		
Elev.	2203	Location	NE NW SE		

330 Ft. From	N	Line	SE
990 Ft. From	W	Line	Quarter

1st. Report

Completion MAY 2 1951

Remarks

Spudding Date 3-25-51

Drig. Data	Oil well	TD 3472
8" @ 185	Heeb. 3326	KC 3353 5" @ 3470
TD 3472	12/ 3455-58	3 gw SSO 8 hr.
24/ 3441-48	21 goph	3000 A S/ 5 $\frac{1}{2}$ boph
Comp. 83 bopd		

J. E. TYRA

County	Phillips		State	Kansas
Sec.	5	(Bk. Twp.)	2	(Sur. Rge.) 18W Map No.
Operator	B & R Drilg. etal.			
Well No.	2	Farm	Inn "C"	
Elev.	2203	Location	NE NW SE	

FIRST REPORT

0

330 Ft. From N Line SE

990 Ft. From W Line Quarter

1st. Report MAR 28 1951

Completion

Remarks

Spudding Date 3-25-51

Drig. Data

8" @ 185 WOC

J. E. TYRA