

**KANSAS**


Phillips

Section 5 Township 2 Range 18W

Well No. #1 Jackson

Company Stabledoor et al

NORTH Hoffstutter

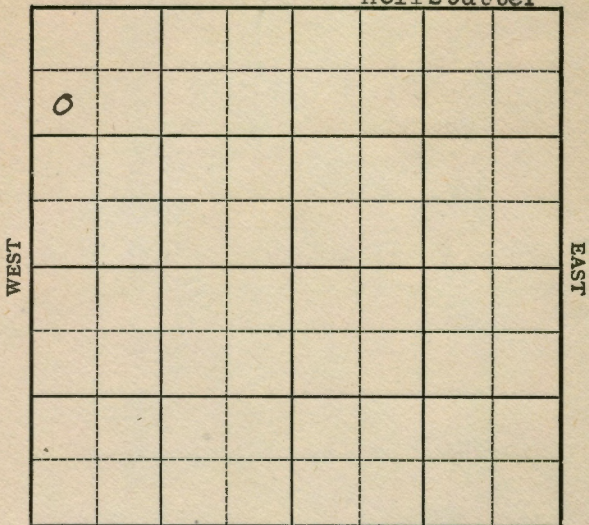

SOUTH

4

**KANSAS**

Phillips

Sec. 5 Twp. 2 R. 18W

Well No. #1 Jackson Farm \_\_\_\_\_

Stabledoor et al Company \_\_\_\_\_

Hoffstutter ( B & R Drlg., Cont )  
Pool


990' Ft. from N. Line

\_\_\_\_\_ Ft. from S. Line

\_\_\_\_\_ Ft. from E. Line

330' Ft. from W. Line

SW NW NW

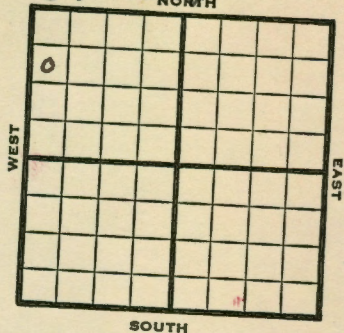

1949

**Elev 2215'** REPORT

- 9/14 RUR
- 9/21 8" @ 165'  
Drlg. 3400'
- 9/28 **Lansing 3354'**  
TD 3470'  
5" @ 3458'  
Swb 8 bbls oil PH 3 hrs.
- 10/5 "
- 10/12 TD 3470'  
**Lansing 3354'**  
5" @ 3448'  
Pump 120 Oil Pot  
28° Gr.  
Comp

**COMPLETED**

Map No. \_\_\_\_\_ Sec. 5 Twp. 2 R. 18W

Well No. 1 Jackson

Stabledoor etal. Company

COMPLETF Contractor

SW NW NW

E 1/2 2215  
SECTION PLAT

990 Ft. from N. Line

\_\_\_\_\_ Ft. from S. Line

\_\_\_\_\_ Ft. from E. Line

330 Ft. from W. Line

0			

Phillips County

Location \_\_\_\_\_

Rig up \_\_\_\_\_

Drilling and Remarks:

*Same 3354*

*5' 03448*

*Comp. 120 oil bit*

*25' 2 1/2*

RECORD

Cased \_\_\_\_\_ in., \_\_\_\_\_ ft.

Sand \_\_\_\_\_

Gas \_\_\_\_\_

Oil \_\_\_\_\_

Total Depth 3470

PRODUCTION

1st 24 hrs. Nat. \_\_\_\_\_

1st 24 hrs. after shot \_\_\_\_\_

Gas \_\_\_\_\_ Cu. Ft.

Dry Hole \_\_\_\_\_

Abandoned \_\_\_\_\_

Date

OCT 12 1949 19

S. J. LEWIS Scout

Map No. \_\_\_\_\_ Sec. 5 Twp. 2 R. 18W

Well No. 1 Jackson

Stabledoor etal. Company

B & R Drig. Contractor

SW NW NW

SECTION PLAT

990 Ft. from N. Line

\_\_\_\_\_ Ft. from S. Line

\_\_\_\_\_ Ft. from E. Line

330 Ft. from W. Line

0			

Phillips County

Location \_\_\_\_\_

Rig up \_\_\_\_\_

Drilling and Remarks:

*RUR*

RECORD

Cased \_\_\_\_\_ in., \_\_\_\_\_ ft.

Sand \_\_\_\_\_

Gas \_\_\_\_\_

Oil \_\_\_\_\_

Total Depth \_\_\_\_\_

PRODUCTION

1st 24 hrs. Nat. \_\_\_\_\_

1st 24 hrs. after shot \_\_\_\_\_

Gas \_\_\_\_\_ Cu. Ft.

Dry Hole \_\_\_\_\_

Abandoned \_\_\_\_\_

Date

SEP 14 1949 19

S. J. LEWIS Scout