


Phillips

KANSASSection 5 Township 2 Range 18-WWell No. #4 JacksonCompany Stabledoor et al
Hufstutter Pool

NORTH

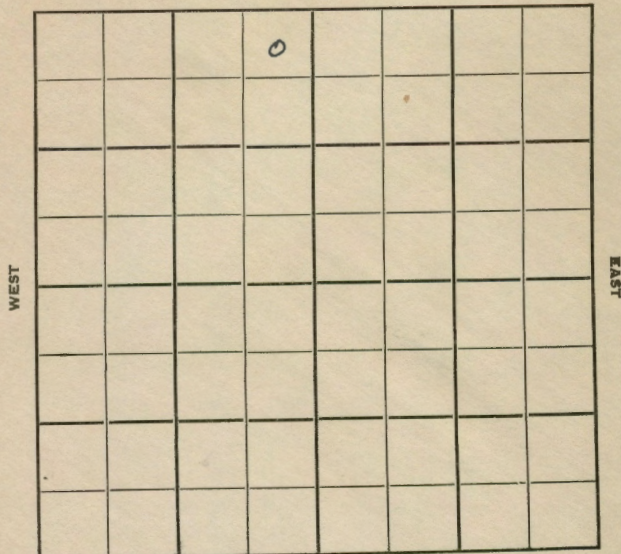

SOUTH

3


Phillips **KANSAS**Sec. 5 Twp. 2 R. 18W ✓Well No. #4 Jackson FarnStabledoor et al
Hufstutter Pool (B & R Drlg., Contr.) Company330' Ft. from N. Line

Ft. from S. Line

330' Ft. from E. Line

Ft. from W. Line

NE NW

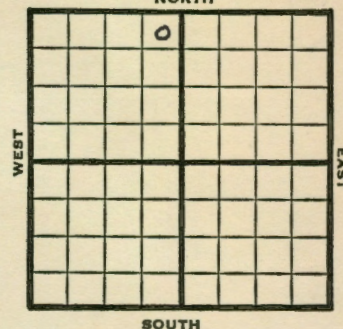

1949

Elev 2199'

REPORT

11/30 Surface Hole

12/7 8" @ 167'

Drlg 3195'

12/14 TD 3451'

5" @ 3451'

12/21 TD 3490'

5500 acid

Swb 2 bbls oil PH

12/28 **Lansing 3340'**

1950

1/11

TD 3490'

8" @ 167'

5" @ 3451'

Plug back to 3455'

5000 acid

Heb 3317'**Lon 3340'**

PB 88 bbls oil per day

No wtr.

Comp

COMPLETED

Kansas

Map No. _____ Sec. 5 Twp. 2 R. 18WWell No. 4 Jackson

Stabledoor etal. _____ Company

Contractor


NE NW

Elev. 2199
SECTION PLAT330 Ft. from N. Line

Ft. from S. Line

330 Ft. from E. Line

Ft. from W. Line

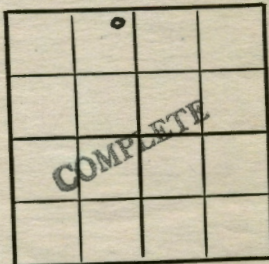

Phillips County

Location _____

Rig up _____

Drilling and Remarks:

8" @ 1675" @ 3451plug back to 34555000 AcidHeb - 3317Lea - 3340PP 88 Bbls Oilper day No water

Date

JAN 11 1950 19

J. E. TYRA

Scout

RECORD

Cased _____ in., _____ ft.

Sand _____

Gas _____

Oil _____

Total Depth 3490

PRODUCTION

1st 24 hrs. Nat. _____

1st 24 hrs. after shot _____

Gas _____ Cu. Ft.

Dry Hole _____

Abandoned _____

Map No. _____ Sec. 5 Twp. 2 R. 18WWell No. 4 Jackson

Stabledoor etal. _____ Company

B & R Drlg.

Contractor


NE NW

FIRST REPORT
SECTION PLAT330 Ft. from N. Line

Ft. from S. Line

330 Ft. from E. Line

Ft. from W. Line

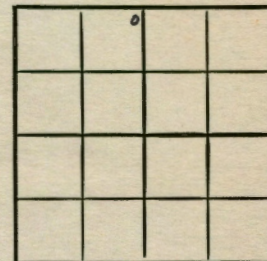

Phillips County

Location _____

Rig up _____

Drilling and Remarks:

surface hole

RECORD

Cased _____ in., _____ ft.

Sand _____

Gas _____

Oil _____

Total Depth _____

PRODUCTION

1st 24 hrs. Nat. _____

1st 24 hrs. after shot _____

Gas _____ Cu. Ft.

Dry Hole _____

Abandoned _____

Date

NOV 30 1949 19

S. J. LEWIS

Scout