


KANSAS

Phillips

Section 5 Township 2 Range 18-W
Well No. #6 Jackson
Company Stable ford et al

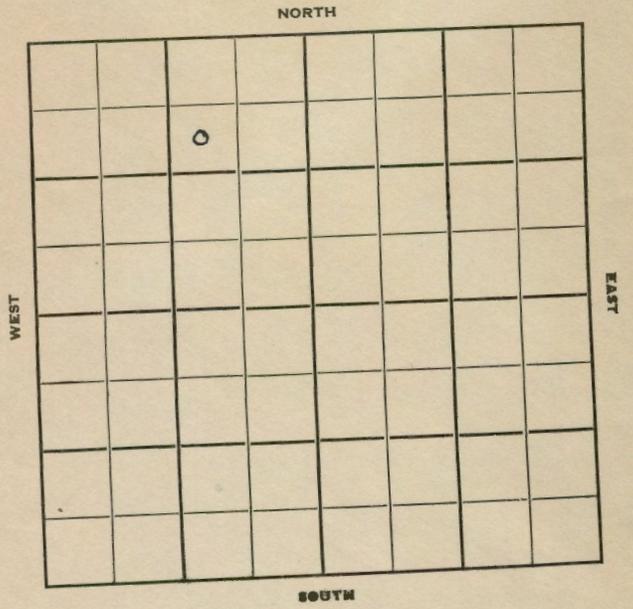


3

Phillips **KANSAS**

Sec. 5 Twp. 2 R. 18W
Well No. #6 Jackson Far
Stableford et al Compan
Huffstutter Contracto

990' Ft. from N. Line
990' Ft. from E. Line
Ft. from S. Line
Ft. from W. Line

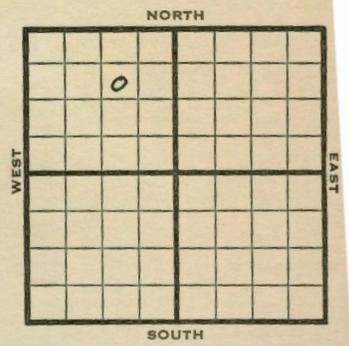

SW NE NW

1950	Elev 2197	REPORT
6/28	Location	
8/30	8" @ 186	
	Heeb 3312	Lans 3336
	5" @ 3445	
	TD 3449	
	B/1 gmph PB 3440	
	23/3422-27, 12/3433-37	
	1000 A	
	S/2 boph 4000 A	
	PB 3416 12/3404-08	
	S/2 boph 4000 A	
	S/9 boph for 16 hr	
	Comp 305 bopd	
	Completed	
	COMPLETED	

