


Section 5 Township 2 Range 18W
Well No. #4 Jackson "B"
Company B & R Drlg.

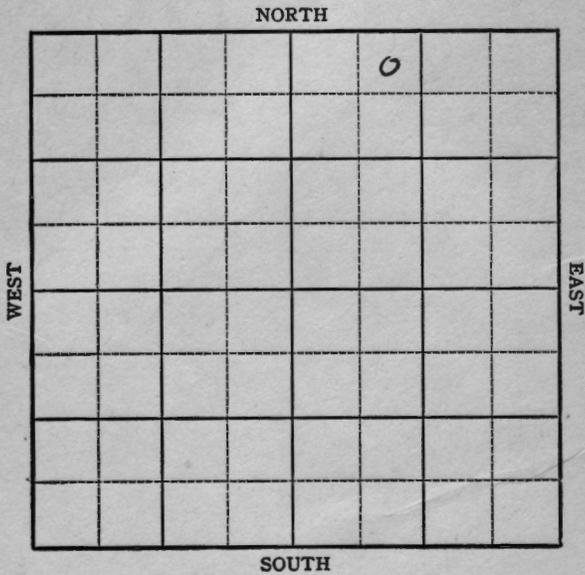


2

Sec. 5 Twp. 2 R. 18 W
Well No. #4 Jackson "B" Farm
B & R Drlg. Company
K & E Drlg. Contractor

330 Ft. from N. Line
Ft. from S. Line
Ft. from E. Line
990 Ft. from W. Line

NE NW NE

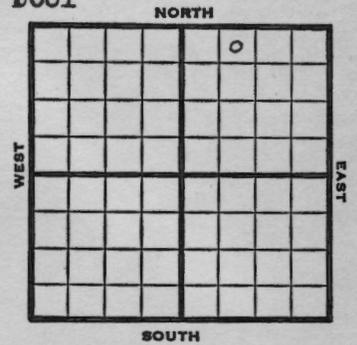

1951 Elev. 2223 REPORT

5/29 Location
8/8 Spud 6-10-51
Oil Well TD 3488
8" @ 180
Heeb. 3347 Lans. 3376
TD 3488 5" @ 3487
12/3466-70 24/3470-79
S/1/2 goph 1500 A S/2 boph
SP 3460 12/3444-48 S/1 boph
1000 A S/3 boph SP 3437
24/3426-32 S/1 1/2 boph 1000 A
S/3 boph CO to 3488
S/4 boph Comp. 88 bopd

COMPLETED

