


Section 5 Township 2 Range 18 W

Well No. # 6 Jackson "B"

Company B & R Drlg.

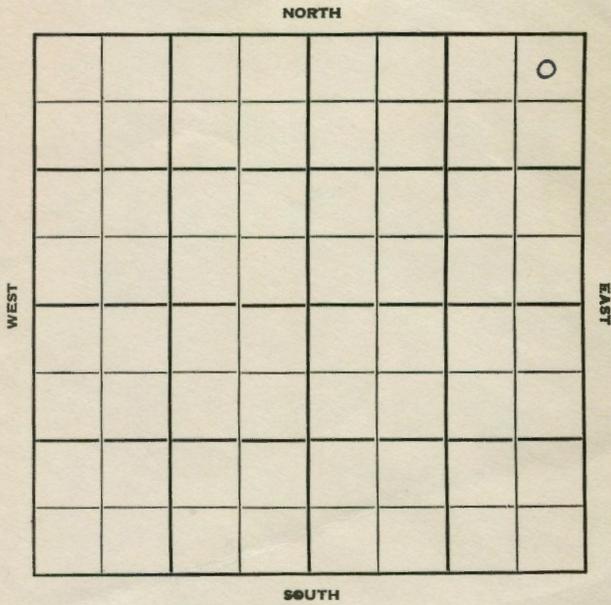

Sec. 5 Twp. 2 R. 18 W

Well No. # 6 Jackson "B"

B & R Drlg.

B & R Drlg.

Huffstutter Pool


330 Ft. from N. Line

_____ Ft. from S. Line

330 Ft. from E. Line

_____ Ft. from W. Line

NE NE NE

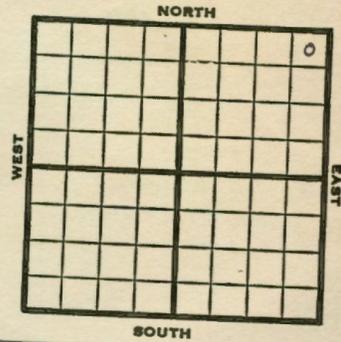

1951 **Elev. 2247'** REPORT

9/26 RUR
 12/12 Spud 9-24-51
 Oil Well TD 3521
 8" @ 190' **Top. 3256 KC 3420**
 TD 3517 5" @ 3517 DD 3521
 10/ 3511-15 6/ 3502-04
 6/ 3498-3500 23/ 3472-78
 23/ 3455-61 1000 A S/ wtr.
 PB 3484 3000 A S/ 1 BOPH
 PB 3443 11/ 3422-26 1 GOPH
 1000 A S/ 4 BOPH 3000 A
 S/ 6 BOPH DP to 3483
 S/ 7 BOPH Comp. 93 BOPD

COMPLETED

County **Phillips** State **Kansas**
 Sec. **5** (Blk.) **2** (Sur.) **18W** Map No.
 Operator **B & R Drlg.**
 Well No. **6** Farm **Jackson "B"**
 Elev. **2247** Location **NE NE NE**

330 Ft. From **N** Line **NE**
330 Ft. From **E** Line **Quarter**
 Ist. Report
 Completion **DEC 1 2 1951**
 Remarks **Huffstutter Pool**
B & R Drlg. - Contr.
 Spudding Date **9-24-51**

Drlg. Data **Oil well** **TD 3521**
8" @ 190 **Top. 3256** **KC 3420**
TD 3517 **5" @ 3517** **DD 3521**
10/ 3511-15 **6/ 3502-04** **6/ 3498-3500**
23/ 3472-78 **23/ 3455-61** **1000 A**
S/ water **PB 3484** **3000 A** **6/ 1 boph**
PB 3443 **11/ 3422-26** **1 goph** **1000 A**
S/ 4 boph **3000 A** **S/ 6 boph**
DP to 3483 **S/ 7 boph** **Comp. 93 bopd**

J. E. TYRA

County **Phillips** State **Kansas**
 Sec. **5** (Blk.) **2** (Sur.) **18W** Map No.
 Operator **B & R Drlg.**
 Well No. **6** Farm **Jackson "B"**
 Elev. Location **NE NE NE**

330 Ft. From **N** Line **NE**
330 Ft. From **E** Line **Quarter**
 Ist. Report **SEP 2 6 1951**
 Completion
 Remarks
B & R Drlg. - Contr.
 Spudding Date

Drlg. Data **Huffstutter Pool**

RUR

J. E. TYRA