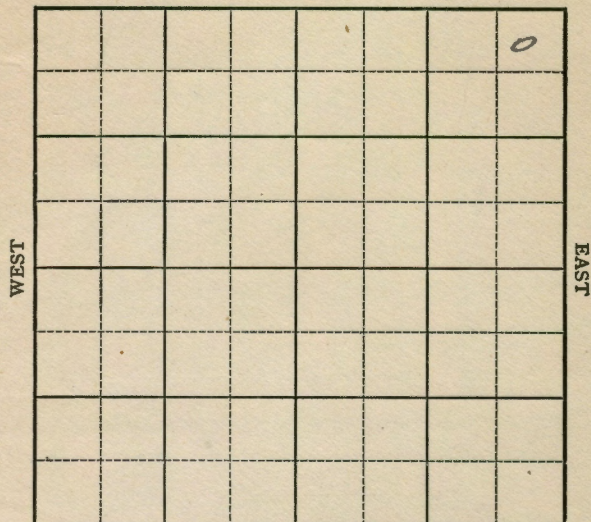


KANSAS

Phillips

Section 6 Township 2 Range 18WWell No. 1 Huffstter

Well No. _____

Company StabledoorWildcat
NORTH

SOUTH

Phillips


KANSAS ✓Sec. 6 Twp. 2 R. 18WWell No. #1 Huffstter Farm _____Stabledoor
Wildcat (B&R, Cont.) Company _____330' Ft. from N. Line

_____ Ft. from S. Line

330' Ft. from E. Line

_____ Ft. from W. Line

NE/C

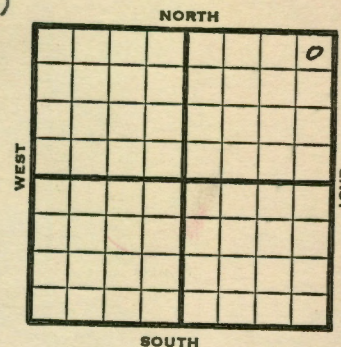1949 **Elev. 2236'** REPORT

8/3 8" @ 170'

8/10 **Lansing 3375'**

TD 3449'

SO

8/17 "

8/24 TD 3480 Sw & 2 1/4 bbls oil PH 8 hrs.

8/31 "

9/7 **Lans 3375'**

5" @ 3380'

Pump 58 oil Pot.

Grav. 35.4

TD 3480'

COMPLETED

Map No. K139 Sec. 6 Twp. 2 R. 18W

Well No. 1 Huffstutter

Stabledoor

Company

COMPLETE

Contractor

NE/C

E. 2236

SECTION PLAT

330 Ft. from N. Line

Ft. from S. Line

330 Ft. from E. Line

Ft. from W. Line

Phillips County

Location

RECORD

Cased in. ft.

Sand

Gas

Oil

Total Depth 3470

PRODUCTION

1st 24 hrs. Nat.

1st 24 hrs. after shot

Gas Cu. Ft.

Dry Hole

Abandoned

Date

SEP 7 1949

19

S. J. LEWIS

Scout

Map No. Sec. 6 Twp. 2 R. 18W

Well No. 1 Huffstutter

Stabledoor

Company

B & R

FIRST REPORT

Contractor

NE/C

SECTION PLAT

330 Ft. from N. Line

Ft. from S. Line

330 Ft. from E. Line

Ft. from W. Line

Phillips County

Location

RECORD

Cased in. ft.

Sand

Gas

Oil

Total Depth

PRODUCTION

1st 24 hrs. Nat.

1st 24 hrs. after shot

Gas Cu. Ft.

Dry Hole

Abandoned

Date

AUG 3 1949

19

S. J. LEWIS

Scout