


Phillips **KANSAS**

Section 6 Township 2 Range 18W

Well No. #5 Ruffstutter

Company B & R and Stableford

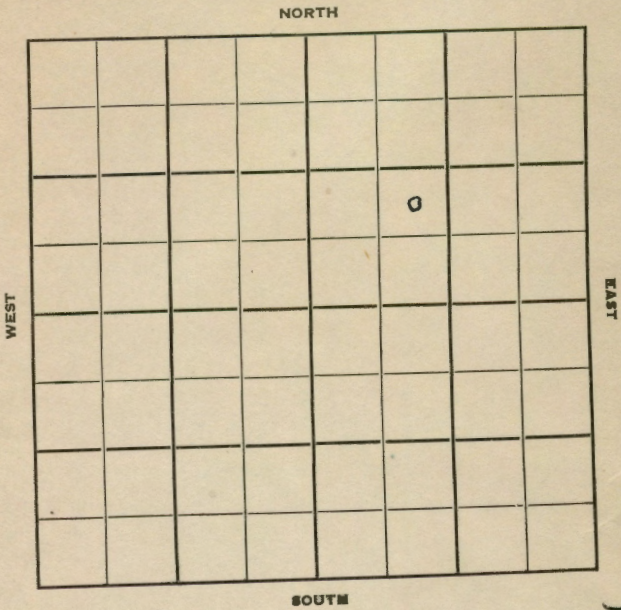

Phillips **KANSAS** 18W


Sec. 6 Twp. 2 R. 18W

Well No. #5 Huffstutter Far

B & R and Stableford Compar

Huffstutter Contract

_____ Ft. from N. Line
 990' _____ Ft. from S. Line
 _____ Ft. from E. Line
 990' _____ Ft. from W. Line
 NE SW NE

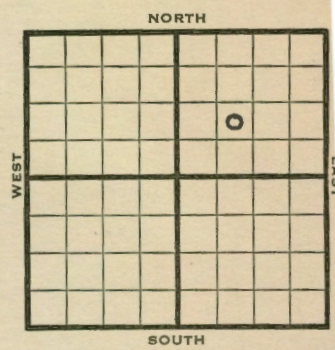

| 1950 | Elev 2250 | REPORT |
|------------------|--|-----------|
| 8/23 | Spud 8-20-50 8-5/8" @ 178' | |
| 9/20 | 8 5/8" @ 178 Anhy 1795 Lans 3382 TD 3516 5" @ 3516 DD 3521 35/3479-86, 12/3492-96 Rec mud & SSO bad cement job SP 3466 24/3455-62 3000 A S/4.32 boph 6 hr SP 3447 24/3436-44 S/3 boph 4000 A S/8 1/2 boph Comp. 283 bopd Completed | Heeb 3357 |
| COMPLETED | | |

