



FORM 51 25M 3-49 PETROL **KANSAS** Phillips  
 Section 6 Township 2 Range 18-W  
 Well No. #6 Huffstutter  
 Company B & R Drlg.

FORM 252-B  
 10M 9-49 PETROL Phillips **KANSAS**  
 Sec. 6 Twp. 2 R. 18W  
 Well No. #6 Huffstutter "A" Farm  
 Company B & R Drlg.

Contractor B & R Drlg. - Contr.  
Huffstutter

330' Ft. from N. Line  
 \_\_\_\_\_ Ft. from S. Line  
 \_\_\_\_\_ Ft. from E. Line  
990' Ft. from W. Line

NE NW NE

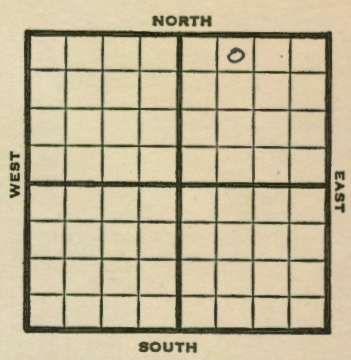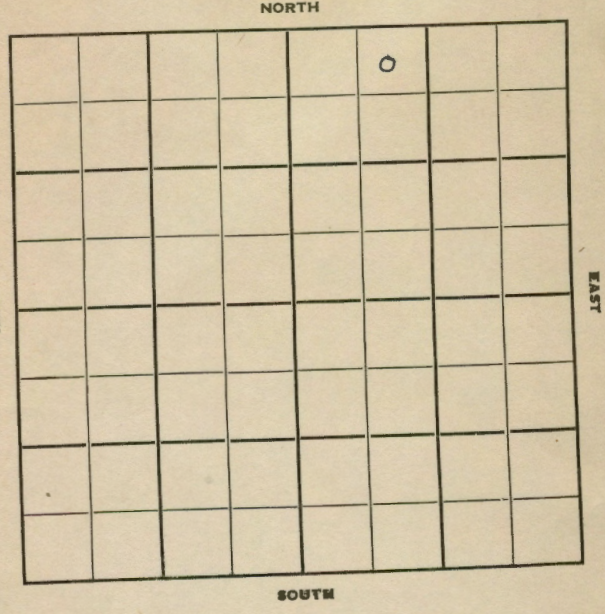

1950	Elev. 2236'	REPORT
10/4	Cellar & Pits	
11/29	Oil Well TD 3507	
	8" @ 182' Heeb 3361'	
	Lans. 3393' TD 3507'	
	5 1/2" @ 3504' 23/3499-3505	
	S/2 1/2 goph 1000 A S/1 BOPH	
	SP 3486 24/3461-66 S/6 goph 1000 A	
	S/2 1/2 boph 3000 A S/5 boph	
	Comp. 140 bopd	
	<b>COMPLETED</b>	

2

County Phillips State Kansas  
 Sec. 6 (Blk. 2 (Sur. 18W Map No.  
 Operator B & R Drlg.  
 Well No. 7 Farm Huffstutter "A"  
 Elev. 2236 Location NE NW NE

			0	

330 Ft. From N Line NE  
 990 Ft. From W Line Quarter  
 1st. Report  
 Completion NOV 29 1950  
 Remarks Huffstutter Pool  
B & R Drlg. - Contr.  
 Spudding Date 10-5-50

Drlg. Data Oil well TD 3507  
8" @ 182 Heeb. 3361 Lens. 3393  
TD 3507 5 1/2" @ 3504 23/ 3499-3505  
S/ 2 1/2 goph 1000 A S/ 1 boph SP 3486  
24/ 3461-66 S/ 6 goph 1000 A S/ 2 1/2 bop  
3000 A S/ 5 boph Comp. 140 bopd

J. E. TYRA

County Phillips State Kansas  
 Sec. 6 (Blk. 2 (Sur. 18W Map No.  
 Operator B & R Drlg.  
 Well No. 6 Farm Huffstutter  
 Elev. 2236 Location NE NW NE

			0	

330 Ft. From N Line NE  
 990 Ft. From W Line Quarter  
 1st. Report OCT 4 1950  
 Completion  
 Remarks  
B & R Drlg. - Contr.  
 Spudding Date

Drlg. Data Huffstutter Pool  
Cellar & pits

J. E. TYRA

Map No. \_\_\_\_\_ Sec. 6 Twp. 2 R. 18W

Well No. 7 Huffstutter "A"

B & R Drlg. Company

CORRECTION Contractor

NE NW NE

SECTION PLAT

330 Ft. from N. Line

\_\_\_\_\_ Ft. from S. Line

\_\_\_\_\_ Ft. from E. Line

990 Ft. from W. Line

		<u>4</u>	

Phillips County

Location \_\_\_\_\_

Rig up \_\_\_\_\_

Drilling and Remarks:

Reported

#6

RECORD

Cased \_\_\_\_\_ in., \_\_\_\_\_ ft.

Sand \_\_\_\_\_

Gas \_\_\_\_\_

Oil \_\_\_\_\_

Total Depth \_\_\_\_\_

PRODUCTION

1st 24 hrs. Nat. \_\_\_\_\_

1st 24 hrs. after shot \_\_\_\_\_

Gas \_\_\_\_\_ Cu. Ft.

Dry Hole \_\_\_\_\_

Abandoned \_\_\_\_\_

Date

OCT 11 1950  
OCT 11 1950

19

J. E. TYRA Scout