

Section 6 Township 2 Range 18W

Sec. 6 Twp. 2 R. 18W

Well No. #3 Imm

Well No. #3 Imm Farm _____


Company Stabledoor et al

Stabledoor et al Company _____

Huffstutter Pool

Huffstutter (B&R Drlg, Cont.)

NORTH

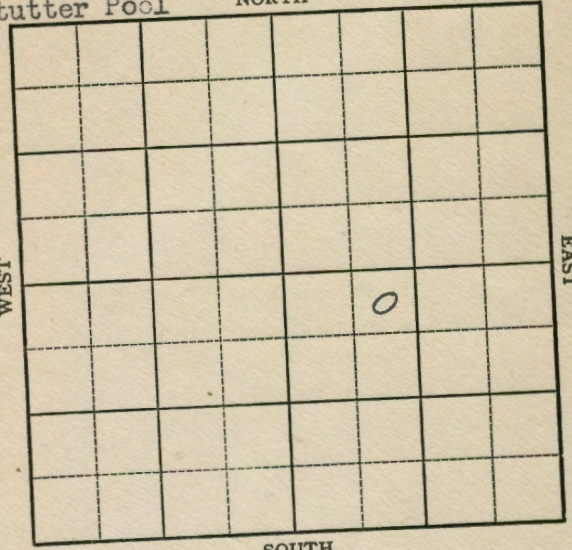


Pool 330' Ft. from N. Line

_____ Ft. from S. Line

_____ Ft. from E. Line

990' Ft. from W. Line

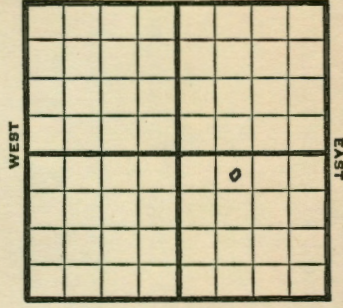

NE NW SE

1949 Elev. 2245' REPORT	
12/14	Location
12/21	RUR
12/28	8" @ 170' Drlg 2280'
1950	
1/25	8" @ 170' 5" @ 3476' Lans. 3375' P/ 341 BOPD TD 3482'
COMPLETED	

10

Kansas

Huffstutter

Map No. _____ Sec. 6 Twp. 2 R. 18W

Well No. 3 Imm

Stabledoor etal. _____ Company

Contractor

NE NW SE

E.O. 2245
SECTION PLAT

330 Ft. from N. Line

_____ Ft. from S. Line

_____ Ft. from E. Line

990 Ft. from W. Line

		o	

Phillips County

Location _____

RECORD

Cased _____ in., _____ ft.

Rig up _____

Sand _____

Drilling and Remarks:

Gas _____

8" @ 170

Oil _____

5" @ 3476

Total Depth 3482

Lens 3375

P-341 BOPD

PRODUCTION

1st 24 hrs. Nat. _____

1st 24 hrs. after shot _____

Gas _____ Cu. Ft.

Dry Hole _____

Abandoned _____

Date

JAN 25 1950 19

J. E. TYRA Scout

Kansas

Huffstutter Pool

Map No. _____ Sec. 6 Twp. 2 R. 18W

Well No. 3 Imm

Stabledoor etal. _____ Company

B & R Drlg. _____ Contractor

NE NW SE

FIRST REPORT
SECTION PLAT

330 Ft. from N. Line

_____ Ft. from S. Line

_____ Ft. from E. Line

990 Ft. from W. Line

		o	

Phillips County

Location _____ X

RECORD

Cased _____ in., _____ ft.

Rig up _____

Sand _____

Drilling and Remarks:

Gas _____

Oil _____

Total Depth _____

PRODUCTION

1st 24 hrs. Nat. _____

1st 24 hrs. after shot _____

Gas _____ Cu. Ft.

Dry Hole _____

Abandoned _____

Date

DEC 14 1949 19

S. J. LEWIS Scout