


Section 6 Township 2 Range 18-W
 Well No. #1 Klizemeyer
 Company B & R Drlg.

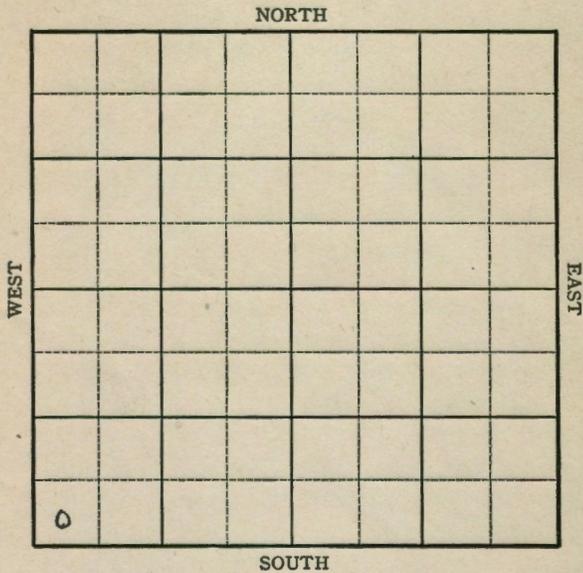

13

Sec. 6 Twp. 2 R. 18W

Well No. #1 Klizemeyer Far
B & R Drlg. Compar


Wildcat

_____ Ft. from N. Line

330 Ft. from S. Line

_____ Ft. from E. Line

330 Ft. from W. Line

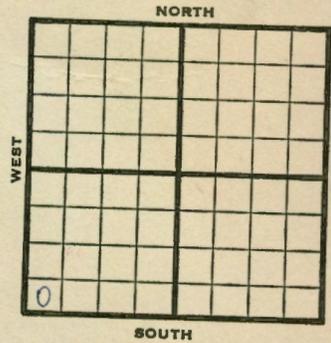

SW/c

1946 **Elev. 2213** REPORT

- 2/27 Location
- 3/7 Surface hole.
- 3/14 8" - 188'
- Drlg. 2069'
- 3/21 **Anhy 1751'**
- Drlg. 3307'
- 3/27 **Lans 3344**
- TD 3455'

ABANDONED

AS Kansas Pool Name Wildcat

139 Sec. 6 Twp. 2 R. 18W

No. 1 Klizemeyer

B & R Drlg. Company

ABANDONED Contractor


SW/c SECTION PLAT

Ft. from N. Line

330 Ft. from S. Line

Ft. from E. Line

330 Ft. from W. Line

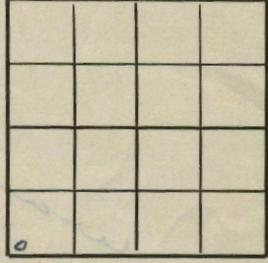

Phillips County

Location _____

Rig up _____

Drilling and Remarks:

None 3344

RECORD

Cased _____ in., _____ ft.

Sand _____

Gas _____

Oil _____

Total Depth 2455

PRODUCTION

1st 24 hrs. Nat. _____

1st 24 hrs. after shot _____

Gas _____ Cu. Ft.

Dry Hole _____

Abandoned _____

Date

MAR 27 1946 19

S. J. LEWIS Scout

KANSAS Kansas Pool Name Wildcat

Map No. 139 Sec. 6 Twp. 2 R. 18W

Well No. 1 Klizemeyer

B & R Drlg. Company

FIRST REPORT Contractor


SW/c SECTION PLAT

Ft. from N. Line

330 Ft. from S. Line

Ft. from E. Line

330 Ft. from W. Line

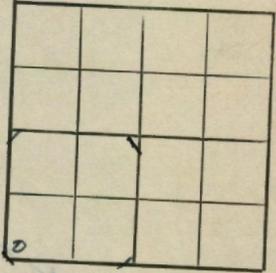

Phillips County

Location _____

Rig up _____

Drilling and Remarks:

RECORD

Cased _____ in., _____ ft.

Sand _____

Gas _____

Oil _____

Total Depth _____

PRODUCTION

1st 24 hrs. Nat. _____

1st 24 hrs. after shot _____

Gas _____ Cu. Ft.

Dry Hole _____

Abandoned _____

Date

FEB 27 1946 19

S. J. LEWIS Scout