


KANSAS

Phillips

Section 6 Township 2 Range 18-W
 Well No. #4 Imm
 Company B & R Drlg. & Stableford

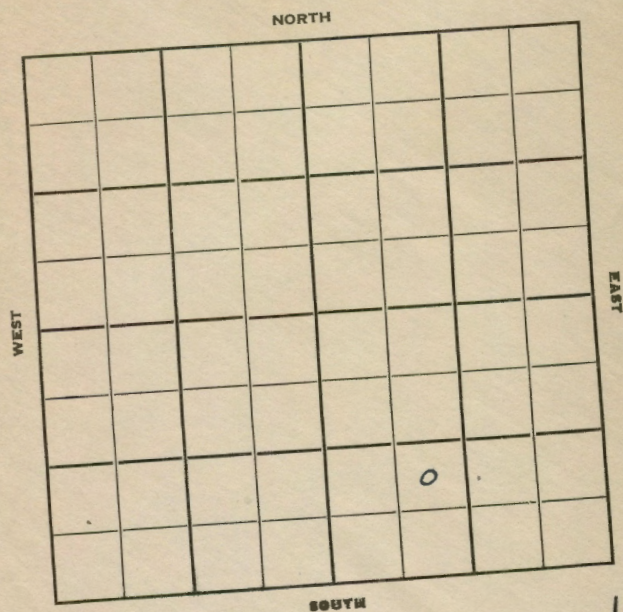

KANSAS

Phillips

Sec. 6 Twp. 2 R. 18W

Well No. #4 Imm Farm

B & R Drlg. & Stableford Company

B & R Drlg. - Contr. Contractor

Huffstutter Pool

Ft. from N. Line

990'


Ft. from S. Line

Ft. from E. Line

990'

Ft. from W. Line

NE SW SE

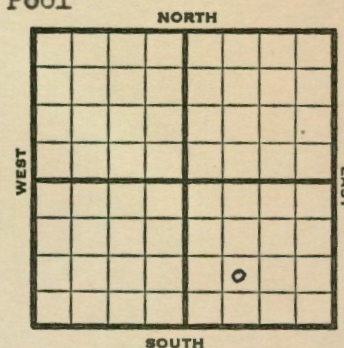

1950

Elev. 2213' REPORT

9/6

Spud 8-30-50

Drlg. 3155'

11/1

Spud 8-30-50

Oil Well TD 3460

KC 3356'

5" @ 3454' TD 3460

B/28 GOPH PB 3456' 1000 A

4/3440 $\frac{1}{2}$ -42 4/3445-47 2 GOPH

1000 A 2 GOPH 8/3454-56

B/2 GOPH 1000 A B/30 GFPH

50% wtr PB 3430

6/3424-26 B/2 $\frac{1}{2}$ GOPH 1000 A

B/10 GO 2 gal acid

PB 3419 12/3398-3402 B/3 GO & WPH


1000 A S/2 BOPH 64/3447-58

S 3/4 BOPH 3000 A S/2-3/4 BOPH

Comp. 100 BOPD

COMPLETED


County Phillips State Kansas
 Sec. 6 (Blk.) 2 (Sur.) 18W Map No.
 Operator B & R Drlg. & Stableford
 Well No. 4 Farm Imm
 Elev. 2222 Location NE SW SE
 990 Ft. From S Line SE
 990 Ft. From W Line Quarter
 1st. Report SEP 6 1950
 Completion
 Remarks
 Spudding Date 8-30-50
 Drig. Data Huffstutter Pool

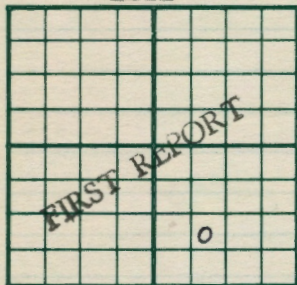

Drig. 3155

J. E. TYRA

County Phillips State Kansas
 Sec. 6 (Blk.) 2 (Sur.) 18W Map No.
 Operator B & R Drlg. & Stableford
 Well No. 4 Farm Imm
 Elev. 2213 Corr. Location NE SW SE
 990 Ft. From S Line SE
 990 Ft. From W Line Quarter
 1st. Report
 Completion NOV 1 1950
 Remarks Huffstutter Pool
B & R Drlg. - Contr.
 Spudding Date 8-30-50
 Drig. Data Oil well TD 3460

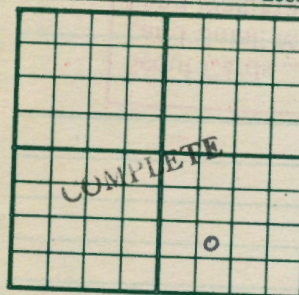

KC 3356 5" @ 3454 TD 3460
B/ 28 goph PB 3456 1000 A 4/ 3440 $\frac{1}{2}$ -42
4/ 3445-47 2 goph 1000 A 2 goph
8/ 3454-56 B/ 2 goph 1000 A B/ 30 gph
50% water PB 3430 6/ 3424-26
B/ 2 $\frac{1}{2}$ goph 1000 A B/ 10 go 2 gal. acid
PB 3419 12/ 3398-3402 B/ 3 go & wph
1000 A S/ 2 boph 64/ 3447-58
S/ 3/4 boph 3000 A S/ 2 3/4 boph
Comp, 1005 bopd

J. E. TYRA