


Section 6 Township 2 Range 18 W

Well No. # 7 Imm "B"

Company B & R Drlg.

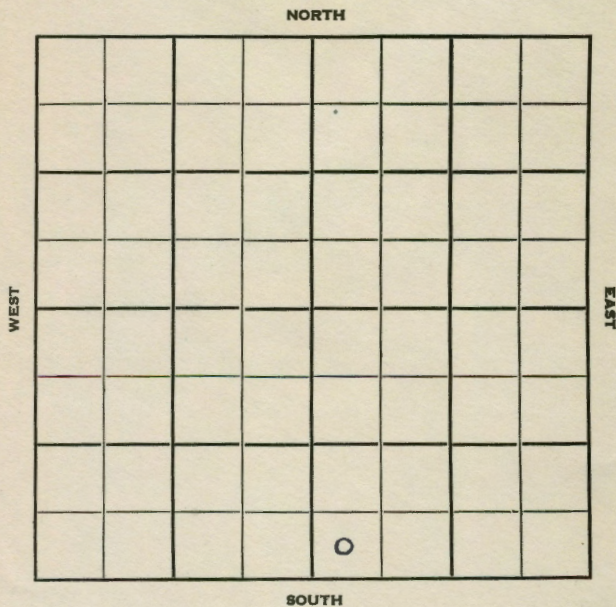

15

Sec. 6 Twp. 2 R. 18 W

Well No. # 7 Imm "B" Farm

B & R Drlg. Company

Huffstutter Pool


Ft. from N. Line

330 Ft. from S. Line

Ft. from E. Line

330 Ft. from W. Line

SW SW SE

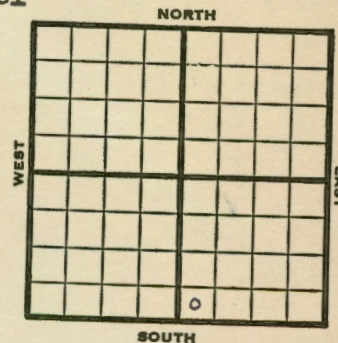

1951 **Elev. 2190'** REPORT

5/2 Cellar & pits  
 9/19 Spud 6-20-51 Oil well TD 3439'  
 8" @ 179 Heeb 3293' Lans. 3320'  
 TD 3437' 5" @ 3437 24/3426-32  
 1000 A S/1 BOPH 20 hr.  
 SP 3414' 12/3398-3402 12/3390-9  
 3000 A S/1/2 BOPH SP 3356'  
 12/3337-41 1000 A S/1/2 BO 2 BWPH  
 SP 3329' 24/3320-26 B/7 GWPH  
 DP. 3329' CO to 3416 Dry  
 PB 3382' 24/3373-80 38/3338-54  
 SW DD 3439' S/24 GW 22 GOPH  
 23/3416-22 35/3426-36 48/3388-  
 3404 500 A S/5 BOPH 2 BWPH  
 Comp. 80 BOPD

**COMPLETED**

