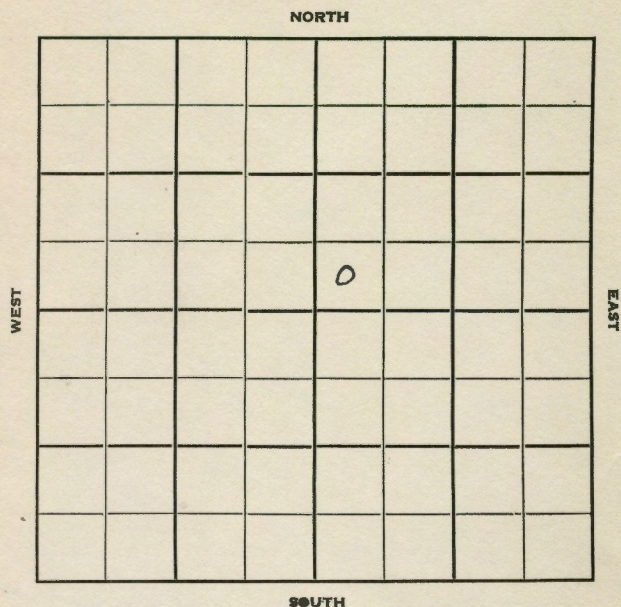


KANSAS

Phillips

Section 6 Township 2 Range 18-WWell No. #6 Huffstutter "A"Company B & R Drlg.

7

KANSAS

Phillips

Sec. 6 Twp. 2 R. 18-WWell No. #6 Huffstutter "A"

B & R Drlg.

B & R Drlg.

Huffstutter

Ft. from N. Line

330


Ft. from S. Line

Ft. from E. Line

330

Ft. from W. Line

SW SW NE

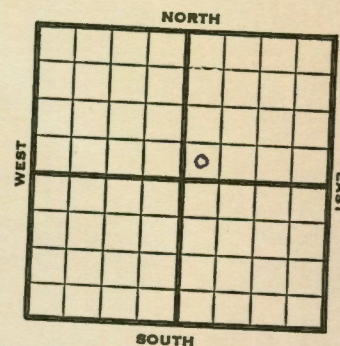

1951

Elev. 2262'

REPORT

1/10

Spud 1-8-51

8" @ 187

WOC

3/28

Spud 1-8-51

8" @ 187

DP to 3521'

3501 12/ 3480-84

34/ 3455-63

S/ 5 boph

Comp. 83 bopd

Oil well

TD 3526'

35/3510-18

B/ 12 goph

Lans. 3407'

TD 3526'

5 1/2" @ 3525

12/3497-

12/ 3472-76

3000 A

COMPLETED

J. E. TYRA

J. E. TYRA