


Section 7 Township 2 Range 18 W

Well No. # 5 Reece "C"

Company B & R Drlg.

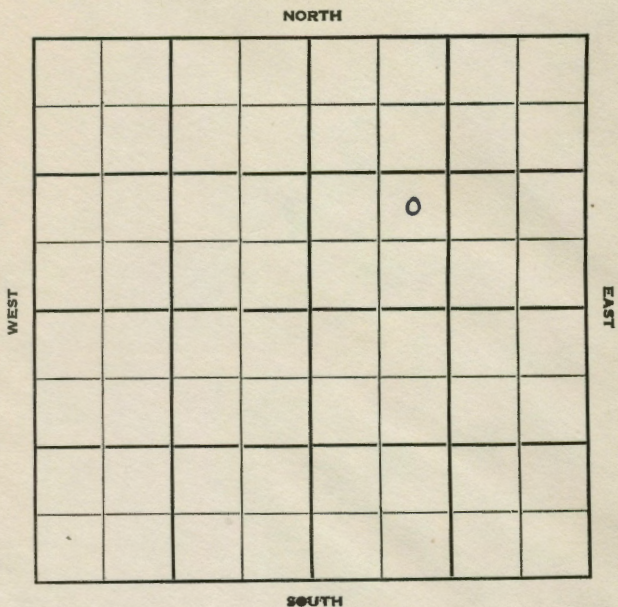

7

Sec. 7 Twp. 2 R. 18 W

Well No. # 5 Reece "C" Farm

B & R Drlg. Company

Contractor

Huffstutter Pool


           Ft. from N. Line

990 Ft. from S. Line

           Ft. from E. Line

990 Ft. from W. Line

NE SW NE

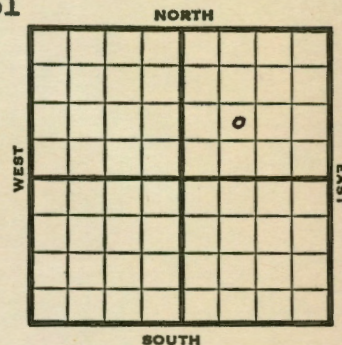

1951 **Elev. 2246'** REPORT

2/14 Spud 2-10-51

8" @ 185'

Drlg. 210'

4/11 Spud 2-10-51

Oil well TD 3495'

8" @ 185' **Top. 3073, Heeb 3344'**

**Lans. 3370'**, 5" @ 3494' 12/3478-83

500 A, S/1 1/2 BOPH SP 3473,

24/ 3464-70, 500 A S/3/4 BOPH

CO to 3454, S/1 1/2 BWPB 24/3390-96

500 A

Comp. 368 BQPD

**COMPLETED**

