


Section 7 Township 2 Range 18W

Well No. #6 Reece "C"

Company B & R Drlg.

NORTH

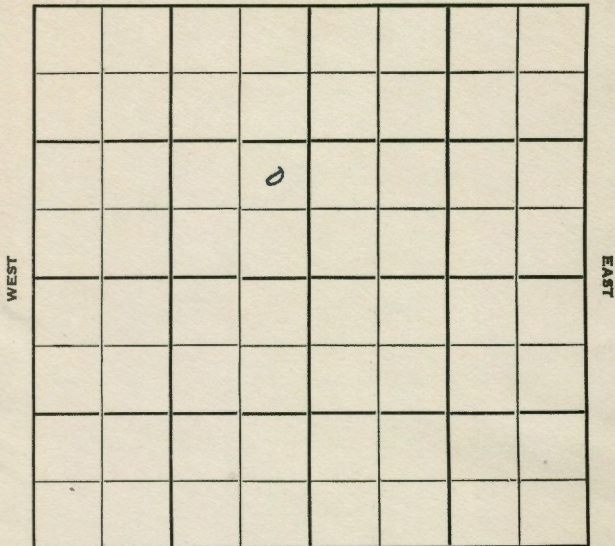

SOUTH

6

Sec. 7 Twp. 2 2 R. 18W

Well No. #6 Reece "C" Farm _____

B & R Drlg. Company _____

B & R Drlg. Contractor _____

Huffstutter Pool

_____ Ft. from N. Line


990 Ft. from S. Line

330 Ft. from E. Line

_____ Ft. from W. Line

NE SE NW

NORTH

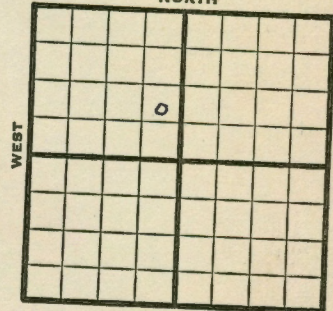

SOUTH

1952 **Elev. 2235'** REPORT

1/2	Spud 12-28-51 8" @ 185' Drlg. 1835'
2/6	Heeb. 3334' KC 3359 TD 3495 5" @ 3493' POP
2/13	No report
2/20	"
3/5	"
3/12	"
3/19	"
3/25	"
4/1	"
4/9	Spud 12-28-51 Oil Well TD 3495' 8" @ 185' Heeb. 3334 KC 3359 TD 3494 5" @ 3493 CO 3495 12/ 3477-81 12/ 3473-77 500 A S/ 2/3 bwph & SO SP 3469 12/ 3462-66 12/ 3458-62 B/ 1/2 bfph 50% oil 12/ 3451-55 2500 A S/ 1-1/3 boph PB 3447 12/ 3441-45 12/ 3433-37 S/ 1-1/3 boph 3000 A S/ 2 1/2 bfph 50% oil PB 3429 12/ 3422-26 11/ 3418-22 11/ 3415-19 S/ 2-2/3 bfph PB 3402 11/ 3387-91

OVER

1952

4/9

12/3382-86 50 A B/ 2 boph
10/3372-76 S/ 1-1/3 boph 2000 A
S/ 2-2/3 bfph DP 3495
S/ 41 bf 9 hr. S/ 2-2/3 bfph
Comp. 78 bopd 32% wtr.

COMPLETED

