


Section 7 Township 2 Range 18WWell No. #1 Reece "O"Company B & R Drlg.

NORTH

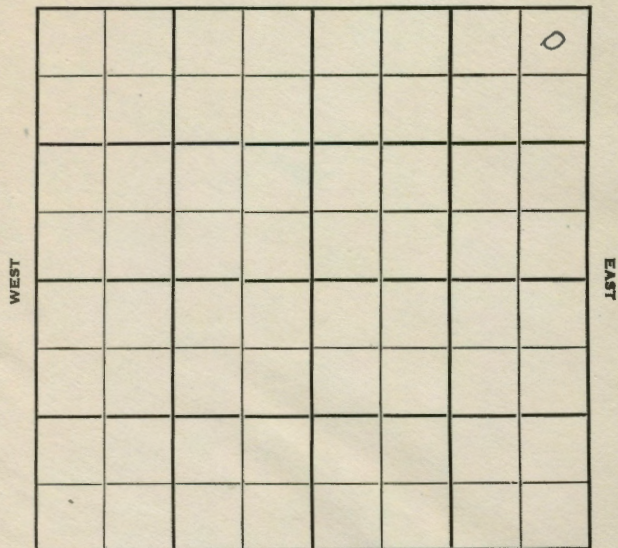

SOUTH

Sec. 7 Twp. 2 R. 18WWell No. #1 Reece "C" ✓ FarmB & R Drlg. CompanyB & R Drlg Contractor

Huffstutter

330 Ft. from N. Line


Ft. from S. Line

330 Ft. from E. Line

Ft. from W. Line

NE NE NE

NORTH

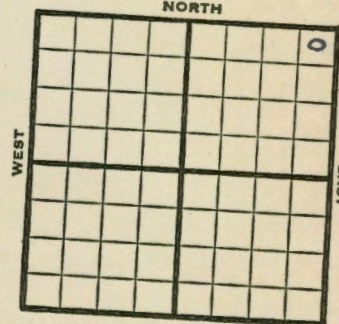

SOUTH

1950

Elev 2176'

REPORT

12/13

8" @ 158

1951
1/31

Drlg 2615'

Oil well TD 3430

8" @ 158

Lans 3293 TD 3430

5" @ 3427 24/3407-15 B/ 10 goph

500 A S/ 1-1/3 goph 2000 A

S/ 1-3/4 boph SP 3400 12/ 3393-97

5 goph 500 A S/ 1 boph SP 3382

24/ 3372-78 1 goph 500 A S/ 4 boph

3000 A S/ 6 boph FU 264' fluid in

10 hr.

Comp. 120 bopd

COMPLETED

County	Phillips		State	Kansas	
Sec.	7	(Blk. Twp.)	2	(Sur. Rge.)	18W Map No.
Operator	B & R Drlg.				
Well No.	1	Farm	Reece "C"		
Elev.	2176	Location	NE NE NE		

330 Ft. From	N	Line	NE
330 Ft. From	E	Line	Quarter
1st. Report			
Completion	JAN 31 1951		
Remarks	Huffstutter Pool		
B & R Drlg. - Contr.			
Spudding Date			

Drilg. Data Oil well TD 3430

8" @ 158 Lans. 3293 TD 3430

5" @ 3427 24/ 3407-15 B/ 10 goph

500 A S/ 1 1/3 goph 2000 A S/ 1 3/4

boph SP 3400 12/3393-97 5 goph

500 A S/ 1 boph SP 3382 24/ 3372-78

1 goph 500 A S/ 4 boph 3000 A

S/ 6 boph FU 264' fluid in 10 hr.

Comp. 120 bopd 1201 833

J. E. TYRA

County	Phillips		State	Kansas	
Sec.	7	(Blk. Twp.)	2	(Sur. Rge.)	18W Map No.
Operator	B & K Drlg.				
Well No.	1	Farm	Reece "C"		
Elev.	2176	Location	NE NE NE		

FIRST REPORT

330	Ft. From	N	Line	NE
330	Ft. From	E	Line	Quarter
1st. Report DEC 13 1950				
Completion				
Remarks				
B & R Drlg. - Contr.				
Spudding Date				

Drig. Data Huffstutter Pool

8" @ 158 drlg. 2615

J. E. TYRA