

Phillips

KANSAS

Sec. 7 Twp. 2 R. 18W

Well No. #2 Kancelmeyer "C" Farm

B & R Drlg. Company

Contractor

Huffstutter Pool


990' Ft. from N. Line

Ft. from S. Line

Ft. from E. Line

330' Ft. from W. Line

SW NW NE

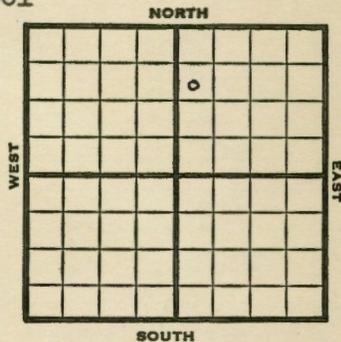

1951 **REPORT**

Elev. 2211'

5/16 Location

7/18 Spud 5-18-51

Oil well	TD 3456'	
8" @ 169	Heeb 3314'	Lans. 3339'
5" @ 3452	TD 3456'	Test $\frac{1}{2}$ gal OCM
per hr.	12/3447-49	S/2/3 BOPH
1000 A	S/3 BOPH	12/3444-48
no inc.	4000 A	S/4 BOPH
SP 3422'	12/3408-12	10 GOPH
1500 A	5 BOPH	
Comp.	83 BOPD	


COMPLETED

KANSAS

Section 7 Township 2 Range 18W

Well No. #2 Kancelmeyer "C"

Company B & R. Drlg.

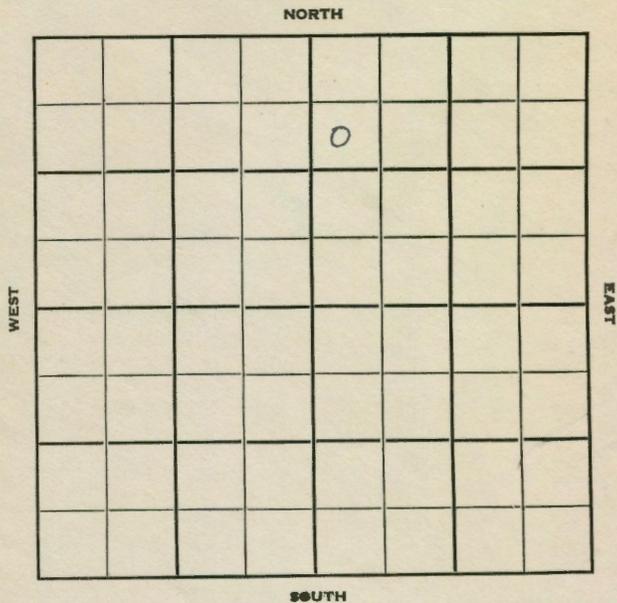

2

