


Section 7 Township 2 Range 18 WWell No. # 1 KlizemeyerCompany B & R Drlg.

NORTH

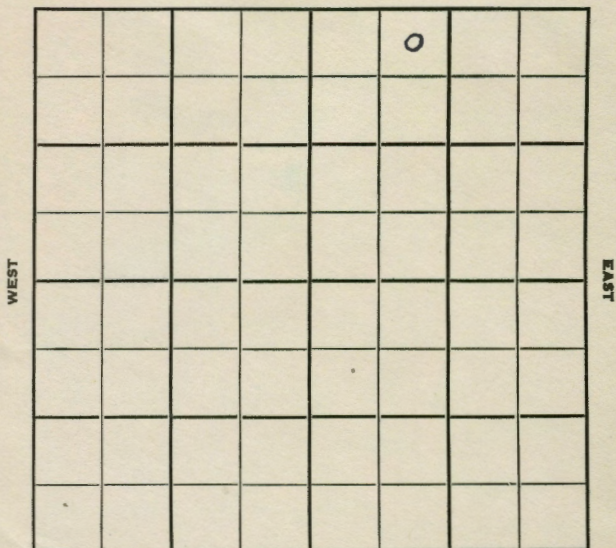

SOUTH

2

Sec. 7 Twp. 2 R. 18W ✓Well No. #1 Klizemeyer FarmCompany B & R Drlg.

Contractor

Huffstutter Pool

330' Ft. from N. Line


Ft. from S. Line

Ft. from E. Line

990' Ft. from W. Line

NE NW NE

NORTH

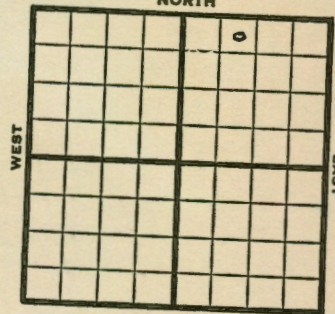

SOUTH

1951

Elev. 2184'

REPORT

4/25

Location

6/27

Spud 4-26-51

Oil Well TD 3429

8" @ 175

Anhy 1745 Heeb. 3285

Lans. 3311

TD 3429

5" @ 3429

34/3418-27 B/40 goph 23/3405-14

B/55 Goph 4000 A S/8 boph

Comp. 81 bopd

COMPLETED

County **Phillips** State **Kansas**  
 Sec. **7** (Blk. **2**) (Sur. **18W**) Map No.  
 Operator **B & R Drilg.**  
 Well No. **1** Farm **Kanzelmeyer**  
 Elev. **2184** Location **NE NW NE**

**330** Ft. From **N** Line **NE**  
**990** Ft. From **W** Line **Quarter**  
 Ist. Report  
 Completion **JUN 27 1951**  
 Remarks **Huffstutter Pool**

Spudding Date **4-26-51**

Drilg. Data **Oil well** **TD 3429**

**8" @ 175** **Anhy 1745** **Heeb. 3285**

**Lans. 3311** **TD 3429** **5" @ 3429**

**34/ 3418-27** **B/ 40 goph** **23/ 3406-14**

**B/ 55 goph** **4000 A** **S/ 8 boph**

**Comp. 81 bopd**

**J. E. TYRA**

County **Phillips** State **Kansas**  
 Sec. **7** (Blk. **2**) (Sur. **18W**) Map No.  
 Operator **B & R Drilg.**  
 Well No. **1** Farm **Klizemeyer**  
 Elev. Location **NE NW NE**

**330** Ft. From **N** Line **NE**  
**990** Ft. From **W** Line **Quarter**  
 Ist. Report **APR 25 1951**  
 Completion  
 Remarks

Spudding Date

Drilg. Data

**Location**

**Huffstutter Pool**

**J. E. TYRA**