


Phillips

Phillips

Section 18 Township 2 Range 18-W
 Well No. #1 Dill
 Company B & R Drlg.

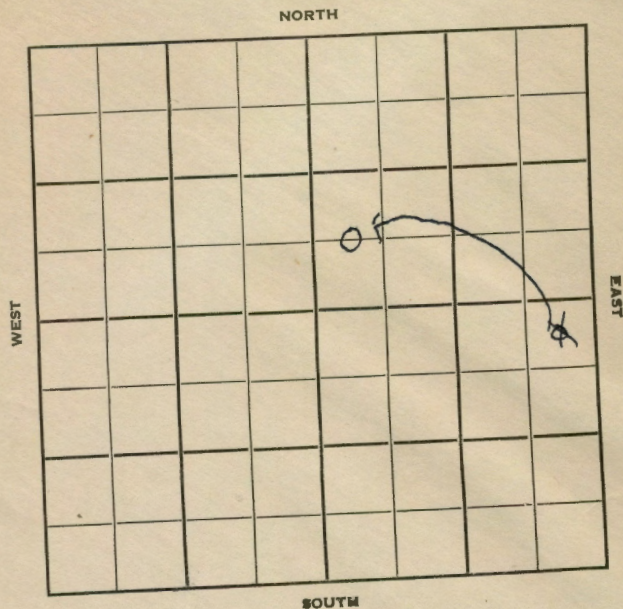

SOUTH

7

Phillips

KANSAS

Sec. 18 Twp. 2 R. 18W
 Well No. #1 Dill
 B & R Drlg.
 Company
 Contractor

Wildcat

330+ Ft. from N. Line


660 Ft. from S. Line

330+ Ft. from E. Line

330 Ft. from W. Line

~~NE NE SE~~

C W S SW NE

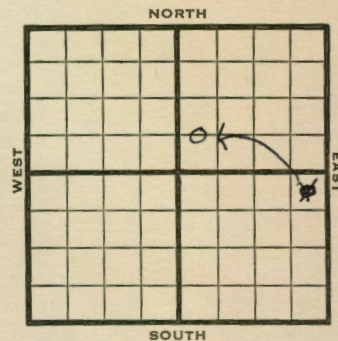

1950

Elev 2188

REPORT

8/16

Spud 8-9-50

8" @ 182'

Anhy 1805'

Drlg. 2885'

8/23

8" @ 182'

Anhy 1805'

Heeb 3408

TD 3573

D&A

Top 3180

Lans 3442

ABANDONED

Kansas

Map No. _____ Sec. 18 Twp. 2 R. 18WWell No. 1 Dill

B & R Drlg.

Company

CORRECTION

Contractor

C W L SW NE

SECTION PLAT

_____ Ft. from N. Line

660 Ft. from S. Line

_____ Ft. from E. Line

330 Ft. from W. Line

Phillips County

Location _____

Rig up _____

Drilling and Remarks:

Reported

NE NE SE

RECORD

Cased _____ in., _____ ft.

Sand _____

Gas _____

Oil _____

Total Depth _____

PRODUCTION

1st 24 hrs. Nat. _____

1st 24 hrs. after shot _____

Gas _____ Cu. Ft.

Dry Hole _____

Abandoned _____

Date

AUG 23 1950 19

J. E. TYRA

Scout

County **Phillips** State **Kansas**
 Sec. **18** (Blk. **2** (Sur. **18W** Map No.
 Operator **B & R Drlg.**
 Well No. **1** Farm **Dill**
 Elev. Location **NE NE SE**

330 Ft. From **W** Line **NE**
330 Ft. From **W** Line Quarter
 1st. Report **AUG 16 1950**
 Completion
 Remarks
 Spudding Date **8-9-50**
 Drlg. Data **Wildcat**
8" @ 182 Anhy 1805 drlg. 2885

J. E. TYRA

County **Phillips** State **Kansas**
 Sec. **18** (Blk. **2** (Sur. **18W** Map No.
 Operator **B & R Drlg.**
 Well No. **1** Farm **Dill**
 Elev. **2188** Location **C W L SW NE**

660 Ft. From **S** Line **NE**
330 Ft. From **W** Line Quarter
 1st. Report
 Completion **AUG 23 1950**
 Remarks
Wildcat
 Spudding Date **8-9-50**
 Drlg. Data **D & A TD 3573**
8" @ 182 Anhy 1805 Top. 3180
Heeb. 3408 Lans. 3442 TD 3573
D & A

J. E. TYRA