

Phillips County

FORM 51 5M 6-46 PETROL


Dayton Pool

KANSAS

Section 18 Township 2 Range 18W

Well No. 1 Reece

Company B & R Drlg.

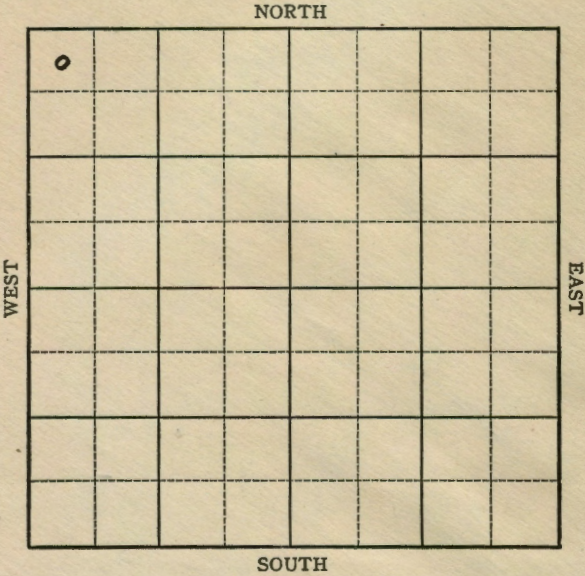

4

FORM 252-A  
5M 12-45 PETROL

KANSAS

Phillips

Sec. 18 Twp. 2 R. 18-W

Well No. #1 Reece Farm


B & R Drlg. Company

330 Ft. from N. Line

Ft. from S. Line

Ft. from E. Line

330 Ft. from W. Line

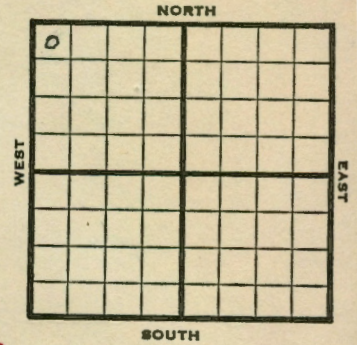

NW/C Elev. 2153'

REPORT

1947	
2/26	8" @ 162' WOC
3/4	Drlg 3170'
3/11	Land 3253' TD 3350' 5" @ 3347' RUST
3/18	TD 3350' 1750' oil in 5 days
3/18	TD 3352' 2000 Acid Swab 2 bbls oil PH 8 hrs
4/2	" "
4/9	" "
4/15	" "
4/23	" "
4/28	" "

OVER

5/7

Lens 3253'  
5" @ 3347  
2000 Acid  
Pump 87 Pot  
Grav. 28  
TD 3350'

COMPLETED

KANSAS

Dayton Pool

Kansas

Map No. 139 Sec. 18 Twp. 2 R. 18W

Well No. 1 Reece

B & R drlg. Company

COMPLETE Contractor

NW/C

E12158  
SECTION PLAT

330 Ft. from N. Line

0			

Ft. from S. Line

Ft. from E. Line

330 Ft. from W. Line

Phillips County

Location \_\_\_\_\_

RECORD

Cased \_\_\_\_\_ in., \_\_\_\_\_ ft.

Rig up \_\_\_\_\_

Sand \_\_\_\_\_

Drilling and Remarks:

Gas \_\_\_\_\_

Lane 3253

Oil \_\_\_\_\_

5' 3347

Total Depth 3350

2000 acid

Pump 870 ft

PRODUCTION

1st 24 hrs. Nat. \_\_\_\_\_

1st 24 hrs. after shot \_\_\_\_\_

Gas \_\_\_\_\_ Cu. Ft.

Dry Hole \_\_\_\_\_

Abandoned \_\_\_\_\_

280 ft

Date

MAY 7 1947 19 S. J. LEWIS Scout

KANSAS

Dayton Pool

Map No. 139 Sec. 18 Twp. 2 R. 18W

Well No. 1 Reece

B & R Drlg. Company

FIRST REPORT Contractor

NW/C

SECTION PLAT

330 Ft. from N. Line

0			

Ft. from S. Line

Ft. from E. Line

330 Ft. from W. Line

Phillips County

Location \_\_\_\_\_

RECORD

Cased \_\_\_\_\_ in., \_\_\_\_\_ ft.

Rig up \_\_\_\_\_

Sand \_\_\_\_\_

Drilling and Remarks:

Gas \_\_\_\_\_

Oil \_\_\_\_\_

Total Depth \_\_\_\_\_

8" @ 162 WOC

PRODUCTION

1st 24 hrs. Nat. \_\_\_\_\_

1st 24 hrs. after shot \_\_\_\_\_

Gas \_\_\_\_\_ Cu. Ft.

Dry Hole \_\_\_\_\_

Abandoned \_\_\_\_\_

Date

FEB 26 1947 19 S. J. LEWIS Scout