


KANSAS

Section 18 Township 2 Range 18W

Well No. 4 Reece

Company B & R Drlg. Dayton

NORTH

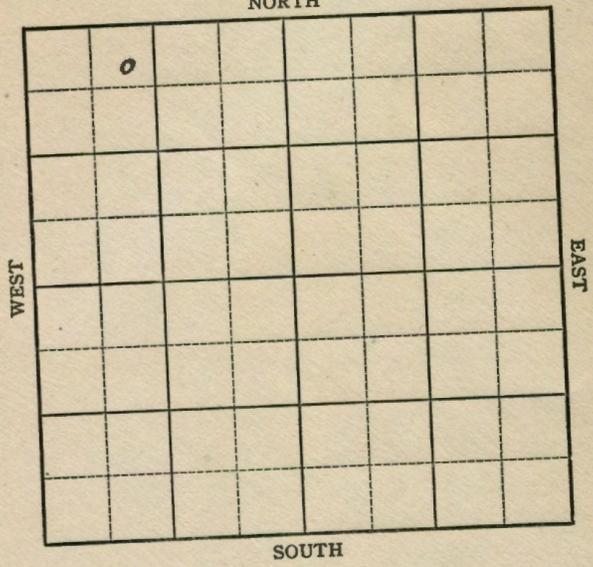

4

KANSAS

Phillips



Sec. 18 Twp. 2 R. 18W

Well No. #4 Reece Farm

B & R Drlg. Company

Dayton Pool (B&R Drlg., Cont.) NORTH


450' Ft. from N. Line

_____ Ft. from S. Line

_____ Ft. from E. Line

990' Ft. from W. Line

NE NW NW

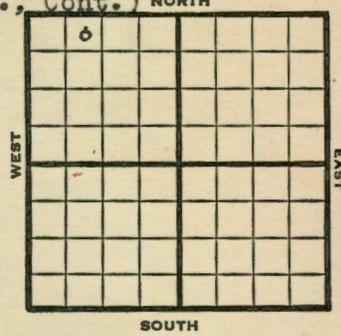

1949	Elev. 2180'	REPORT
5/25	Lans. 3285'	TD 3390'
	5" @ 3282'	"
6/1	"	"
6/7	TD 3395'	2000 acid
	No help	36 shots 3262 -88 sso
6/15	Drlg 3558'	
6/21	TD 3558'	Squeeze
6/28	"	"
7/6	Lans. 3285'	5" @ 3282'
	TD 3395'	ABANDONED

Map No. K139 Sec. 18 Twp. 2 R. 18W

Well No. 4 Reece

B & R Drlg. Company

ABANDONED Contractor

NE NW NW

E 1/2 180
SECTION PLAT

450 Ft. from N. Line

_____ Ft. from S. Line

_____ Ft. from E. Line

990 Ft. from W. Line

o			

Phillips County

Location _____

Rig up _____

Drilling and Remarks:

*Lans. 3285
5" @ 3282*

RECORD

Cased _____ in., _____ ft.

Sand _____

Gas _____

Oil _____

Total Depth 3295

PRODUCTION

1st 24 hrs. Nat. _____

1st 24 hrs. after shot _____

Gas _____ Cu. Ft.

Dry Hole _____

Abandoned _____

Date

JUL 6 1949 19

S. J. LEWIS Scout

Map No. _____ Sec. 18 Twp. 2 R. 18

Well No. 4 Reece

B & R Drlg. Company

B & R Drlg. Contractor

NE NW NW

FIRST REPORT
SECTION PLAT

450 Ft. from N. Line

_____ Ft. from S. Line

_____ Ft. from E. Line

990 Ft. from W. Line

o			

Phillips County

Location _____

Rig up _____

Drilling and Remarks:

Lans. 3285

TD 3390

5" @ 3282

RECORD

Cased _____ in., _____ ft.

Sand _____

Gas _____

Oil _____

Total Depth _____

PRODUCTION

1st 24 hrs. Nat. _____

1st 24 hrs. after shot _____

Gas _____ Cu. Ft.

Dry Hole _____

Abandoned _____

Date

MAY 25 1949 19

S. J. LEWIS Scout