


Section 11 Township 2 Range 19WWell No. #1 MouseleyCompany Honaker Drlg.

NORTH

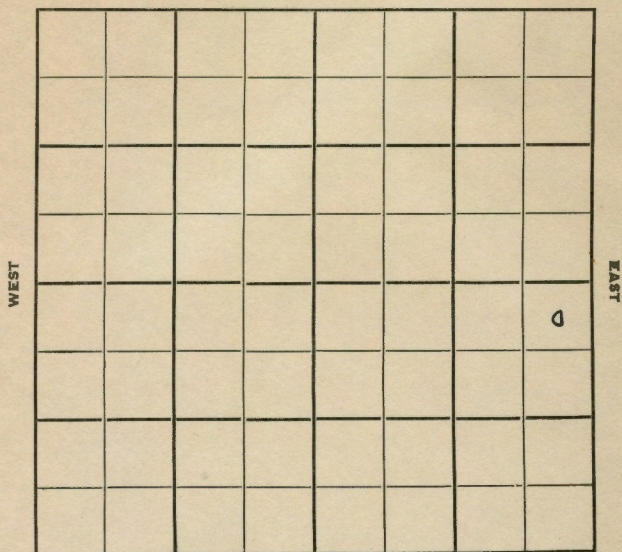

SOUTH

EAST

WEST

9

Sec. 11 Twp. 2 R. 19WWell No. #1 Mouseley FarmHonaker Drlg. Company

Contractor

North Dayton Pool

330' Ft. from N. Line


Ft. from S. Line

330' Ft. from E. Line

Ft. from W. Line

NE NE SE

NORTH

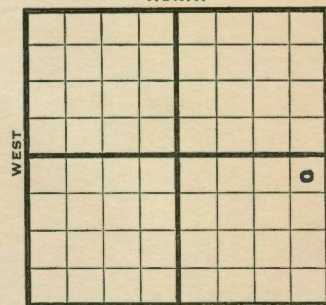

SOUTH

EAST

WEST

1950

Elev 2262

REPORT

8/23

Spud 8-20-50
8-5/8" @ 220'
WOC

8/30

8 5/8" @ 220

Lans 3393

TD 3592

D&A

ABANDONED

County **Phillips** State **Kansas**

Sec. **11** (Bk. **2** (Sur. **19W** Map No.

Operator **Honaker Drig.**

Well No. **1** Farm **Mouseley**

Elev. Location **NE NE SE**

330 Ft. From N Line SE

330 Ft. From E Line Quarter

1st. Report **AUG 23 1950**

Completion

Remarks

Spudding Date **8-20-50**

Drig. Data **North Dayton Pool**

8 5/8" @ 220 WOC

J. E. TYRA

County Phillips State Kansas
Sec. 11 (Blk. Twp.) 2 (Sur. Rge.) 19W Map No.
Operator Honaker Drlg.
Well No. 1 Farm Mouseley
Elev. 2262 Location NE NE SE

330 Ft. From N Line SE
330 Ft. From E Line Quarter
1st. Report
Completion AUG 30 1950
Remarks
North Dayton Pool
Spudding Date 8-20-50
Drlg. Data D & A TD 3592
8 5/8" @ 220 Lans. 3393 TD 3592
D & A

J. E. TYRA