


Phillips

Section 13 Township 2 Range 19W

Well No. 2 Ellis

Company Tom Allan et al

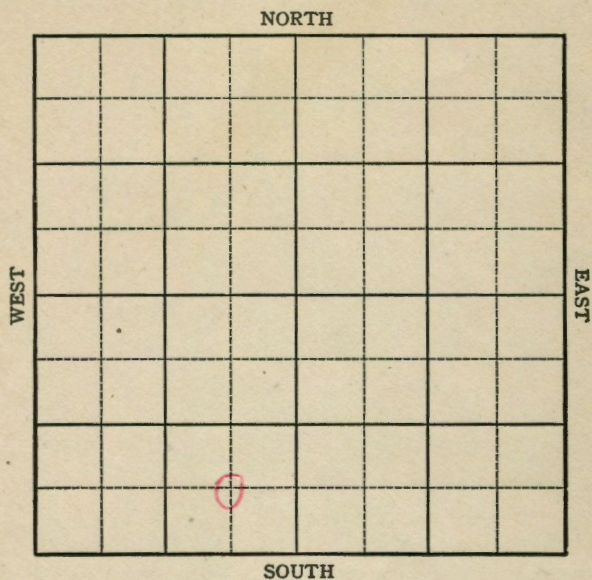

14

5M 6-46 PETROL **KANSAS** Phillips County

Sec. 13 Twp. 2 R. 19W

Well No. #2 Ellis Farm _____

Tom Allan et al Company _____

Dayton

_____ Ft. from N. Line

660 Ft. from S. Line

660 Ft. from E. Line

_____ Ft. from W. Line

C SE SW

1946	2164	REPORT
7/3	Location	
7/9	8" @ 175'	
	Drlg 2660'	
7/16	Anhy 1686	
	5" @ 3359 TD	
	RUST	
7/23	Lans 3270	
	TD 3386'	
	1000 acid 5 gal oil PH	
	23 shots 3328-28-1000 acid	
7/30	Sqz 3323 to 3328, 24 shots	
	327-76, 1000 acid, swb 1½ Oil	
	PH.	
8/6	"	"
8/13	"	"
8/20	"	"
8/28	Lans 3270'	
	5" @ 3357'	
	TD 3386'	
	Perf Lans	
	2000 Acid	
	Pump 40 Pot	
	35.8 GRAV.	
	COMPLETED	

Pool Name Dayton Pool
 Kansas
 Map No. 138 Sec. 13 Twp. 2 R. 19W
 Well No. 2 Ellis

Tom Allan et al

Company

COMPLETED

Contractor

C SE SW

E12164

SECTION PLAT

	0		

Ft. from N. Line

660 Ft. from S. Line

660 Ft. from E. Line

Ft. from W. Line

Phillips County

Location

Rig up

Drilling and Remarks:

Lans 3270

5" (0.225")

Per J. L. Am.

2000 Acid

Pump 40 P. X.

35 5/8"

RECORD

Cased in, ft.

Sand

Gas

Oil

Total Depth 2986

PRODUCTION

1st 24 hrs. Nat.

1st 24 hrs. after shot

Gas Cu. Ft.

Dry Hole

Abandoned

Date

AUG 28 1946 19

S. J. LEWIS

Scout

KANSAS Pool Name Dayton
 Map No. 138 Sec. 13 Twp. 2 R. 19W
 Well No. 2 Ellis

Tom Allan et al.

Company

FIRST REPORT

Contractor

C SE SW

SECTION PLAT

	0		

Ft. from N. Line

660 Ft. from S. Line

660 Ft. from E. Line

Ft. from W. Line

Phillips County

Location X

Rig up

Drilling and Remarks:

RECORD

Cased in, ft.

Sand

Gas

Oil

Total Depth

PRODUCTION

1st 24 hrs. Nat.

1st 24 hrs. after shot

Gas Cu. Ft.

Dry Hole

Abandoned

Date

JUL 3 1946 19

S. J. LEWIS

Sc