


KANSAS

Phillips

FORM 51 5M 10-41 PETROL

Section 13 Township 2 Range 19-W
 Well No. #1 Skelton
 Company John Allen et al.

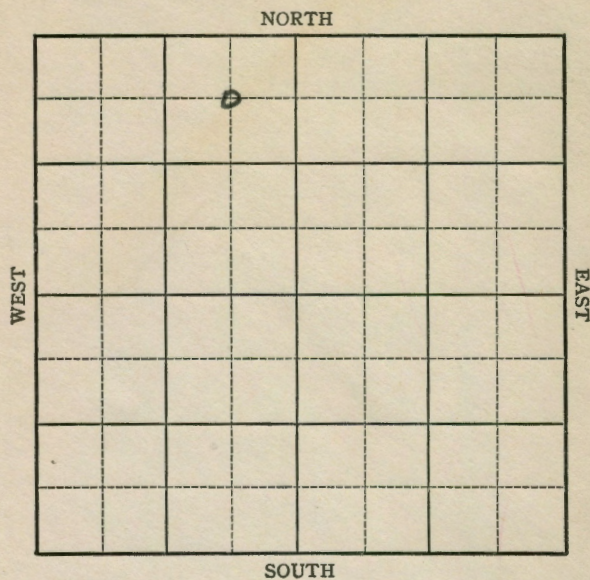

3

Form 252-A
5M 5-42 Petrol

KANSAS

Phillips

Sec. 13 Twp. 2 R. 19-W
 Well No. #1 Skelton Farm
John Allen et al. Company


Dayton Pool

660 Ft. from N. Line

Ft. from S. Line

660 Ft. from E. Line

Ft. from W. Line

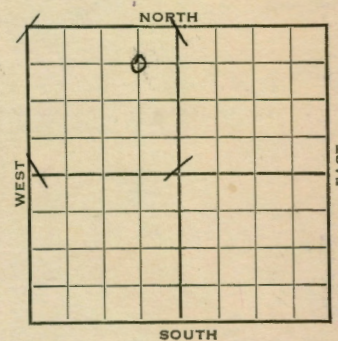

C NE NW

Elev. 2237

1942

REPORT

12/22 Loc.
 12/29 Rotary
 1943
 1/6 8" casing set 108' WOC
 1/13 Drlg. 1700'
 1/20 Drlg. 1850'SD.
 1/27 " " "
 2/3 " " "
 2/10 Lost hole skid rig 10' north.
 Drlg. new hole 234'.
 2/17 Drlg. 2743'
 2/24 Lans 3224
 SSO 3414-18, 3490-95
 Arb. 3701-37TD
 Ran Csg.
 3/3 Lans 3224
 Arb. 3701
 5" @ 3734'
 T.D. 3737'
 48 shots 3488-3502'
 46 shots 3406-22
 2800 gal acid
 Pump 60 Pot
 37 Gravity

COMPLETED

Phillips
KANSAS 138 Sec. 13 Twp. 2 R. 19W
 Map No. 138
 Well No. 1 Skelton

John Allan et al. Company

COMPLETED Contractor

C NE NW


SECTION PLAT

660 Ft. from N. Line

Ft. from S. Line

660 Ft. from E. Line

Ft. from W. Line

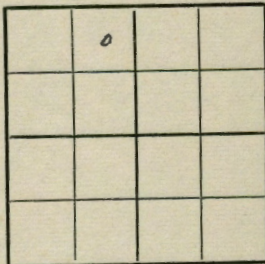

DAYTON POOL

Location

Rig up

Drilling and Remarks:

Lease 8224

Ac 89701

5-103734

48 a lot to 8478-3502

46 " 3406-22

2500 acs

Pump 100 P.D.

Date

37-44

MAR 3 1943 19

S. J. LEWIS Scout

Phillips
KANSAS 138 Sec. 13 Twp. 2 R. 19W
 Map No. 138
 Well No. 1 Skelton

John Allan et al. Company

FIRST REPORT Contractor

C NE NW


SECTION PLAT

660 Ft. from N. Line

Ft. from S. Line

660 Ft. from E. Line

Ft. from W. Line

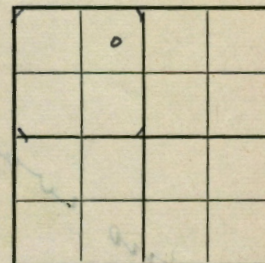

DAYTON POOL

Location XXXX

Rig up

Drilling and Remarks:

RECORD

Cased in, ft.

Sand

Gas

Oil

Total Depth

PRODUCTION

1st 24 hrs. Nat.

1st 24 hrs. after shot

Gas Cu. Ft.

Dry Hole

Abandoned

Date

DEC 22 1942 19

S. J. LEWIS Scout