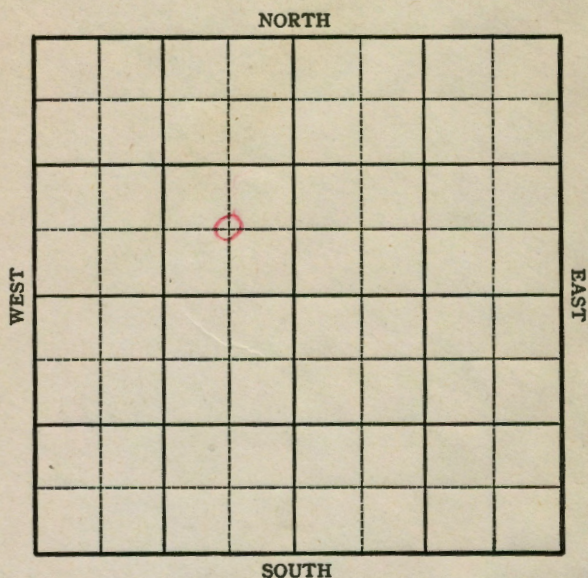


KANSAS Phillips

Section 13 Township 2 Range 19WWell No. 2 SkeltonCompany Tom Allan et al


KANSAS Phillips

Sec. 13 Twp. 2 R. 19WWell No. #2 Skelton FarmTom Allan et al Company

Ft. from N. Line

660 Ft. from S. Line660 Ft. from E. Line

Ft. from W. Line

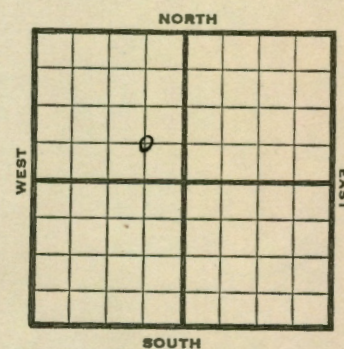

C SE NW

1945 Elev. 2233 REPORT

10/24 Location

10/31 8" @ 219

Drlg. 2138

11/7 Topeka 3092Lans 3318

TD 3388

5" @ 3388 RUST

11/14 Drlg. 3430'

11/21 TD 3439

2000 acid.

2800' oil

12 shots 3370-3376 24

24 shots 3337-3343

24 shots 3316-3322

2000 acid.

Swab 3 o'l per hr.

11/28 " " "

12/5 Lans 3318

5" @ 3388

Perf. Lans 4000 acid.

TD 3439

Pump 60 oil Pot.

Grav. 35.8

COMPLETED

KANSASKansas Pool Name DaytonMap No. 14-138 Sec. 13 Twp. 2 R. 19WWell No. 2 Skelton

Tom Allan et al.

Company

COMPLETED

Contractor

C SE NW

SECTION PLAT

Ft. from N. Line

660 Ft. from S. Line

660 Ft. from E. Line

Ft. from W. Line

Phillips County

Location

Rig up

Drilling and Remarks:


Date

DEC 5 1945 19

S. J. LEWIS Scout

RECORD

Cased _____ in., _____ ft.

Sand _____

Gas _____

Oil _____

Total Depth 3489

PRODUCTION

1st 24 hrs. Nat. _____

1st 24 hrs. after shot _____

Gas _____ Cu. Ft.

Dry Hole _____

Abandoned _____

KANSASKansas Pool Name DaytonMap No. 138 Sec. 13 Twp. 2 R. 19WWell No. 2 Skelton

Tom Allan et al.

Company

FIRST REPORT

Contractor

C SE NW

SECTION PLAT

Ft. from N. Line

660 Ft. from S. Line

660 Ft. from E. Line

Ft. from W. Line

Phillips County

Location X

Rig up

Drilling and Remarks:

RECORD

Cased _____ in., _____ ft.

Sand _____

Gas _____

Oil _____

Total Depth _____

PRODUCTION

1st 24 hrs. Nat. _____

1st 24 hrs. after shot _____

Gas _____ Cu. Ft.

Dry Hole _____

Abandoned _____

Date

OCT 24 1945 19

S. J. LEWIS

Scout