


KANSAS

Phillips C

Section 14 Township 2 Range 19W

Well No. #1 Weinman

Company H. D. Fink et al
Stearns Cont.

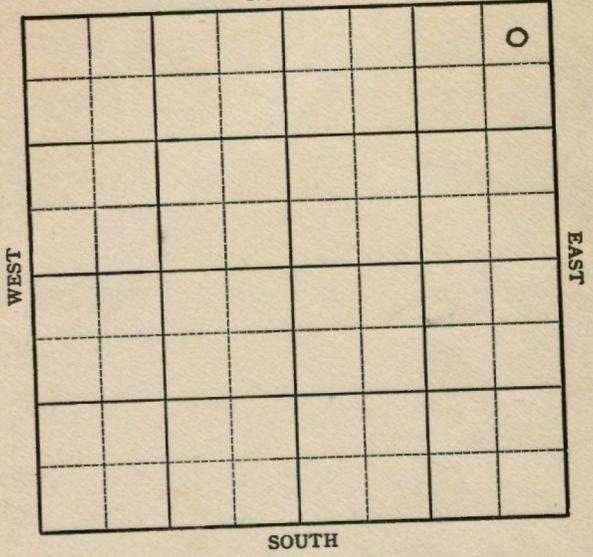

KANSAS Phillips

Sec. 14 Twp. 2 R. 19W

Well No. #1 Weinman Farm

H. D. Fink et al Company
Dayton Pool


330' Ft. from N. Line

_____ Ft. from S. Line

330' Ft. from E. Line

_____ Ft. from W. Line

NE/C

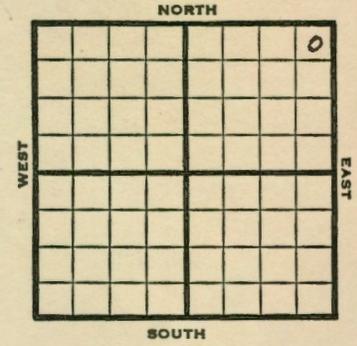

1949	Elev (NO)	REPORT
8/17	8" @ 185'	
8/24	Drlg. 1550'	
	TD 3450'	
	Top 3126'	
	Lans 3345'	
	Aband.	
	ABANDONED	

Map No. K138 Sec. 14 Twp. 2 R. 19W

Well No. 1 Weinman

H. D. Fink et al. Company

ABANDONED Contractor

NE/C

No El.
SECTION PLAT

330 Ft. from N. Line

_____ Ft. from S. Line

330 Ft. from E. Line

_____ Ft. from W. Line

Phillips County

Location _____

Rig up _____

Drilling and Remarks:

*Stop 2126
Ham 2345*

RECORD

Cased _____ in., _____ ft.

Sand _____

Gas _____

Oil _____

Total Depth 2450

PRODUCTION

1st 24 hrs. Nat. _____

1st 24 hrs. after shot _____

Gas _____ Cu. Ft.

Dry Hole _____

Abandoned _____

Date

AUG 24 1949 19

S. J. LEWIS Scout

Map No. _____ Sec. 14 Twp. 2 R. 19W

Well No. 1 Weinman

H. D. Fink et al. Company

Stearns Drlg. Contractor

NE/C

FIRST REPORT
SECTION PLAT

330 Ft. from N. Line

_____ Ft. from S. Line

330 Ft. from E. Line

_____ Ft. from W. Line

Phillips County

Location _____

Rig up _____

Drilling and Remarks:

8" @ 185

drlg. 1550

RECORD

Cased _____ in., _____ ft.

Sand _____

Gas _____

Oil _____

Total Depth _____

PRODUCTION

1st 24 hrs. Nat. _____

1st 24 hrs. after shot _____

Gas _____ Cu. Ft.

Dry Hole _____

Abandoned _____

Date

AUG 17 1949 19

S. J. LEWIS Scout