


Section 12 Township 2 Range 19-WWell No. #4 ArganCompany Phillips

Dayton

NORTH

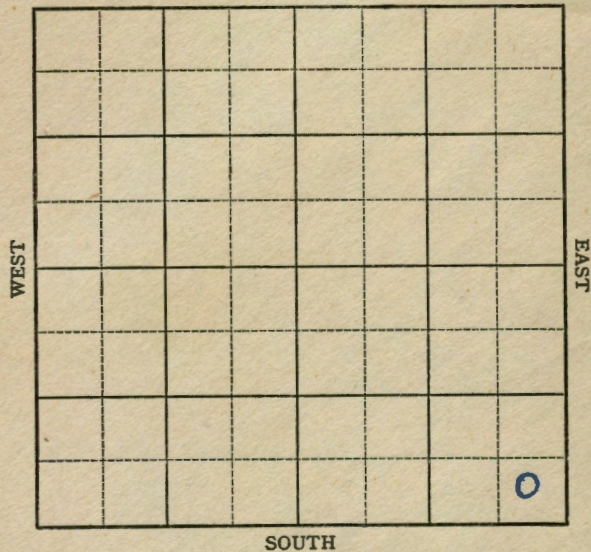

SOUTH

16

Phillips

Sec. 12 Twp. 2 R. 19-WWell No. 4 Argan Farm

Phillips

Company

Dayton Pool


Ft. from N. Line

330 Ft. from S. Line

330 Ft. from E. Line

Ft. from W. Line

SE/C

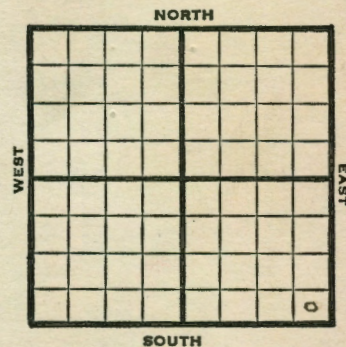

1947

Elev. 2161' REPORT

8/20	RUR
8/27	"
9/3	1500 run 12"
9/10	8" @ 1838' Drlg. 2520'
9/17	Lansing 3240' TD 3357' 5" @ 3357' RUST
9/24	TD 3364' Swab 41 bbls. oil / 6 W in 20 hrs.
10/1	Plug 3302' 20 shots 3279-86' 8 shots 3279-86' - 500 acid Swab 16 bbls. oil in 4 hrs.
10/8	Swb 12 bbls oil & 2 W No time
10/15	"
10/22	"
10/29	Pump 102 bbls oil & 6% W in 24 hrs.
11/5	Pump 40 oil & 20% W in 24 hrs.

OVER

1947

11/12 Pump 40 oil & 20% W in 24 hrs.

11/19 **Lans. 3283'**

5" @ 3354'

Pump 34 oil / 8W Pot.

29.0 Gr.

TD 3364'

Compleat.

COMPLETED

Map No. 138 Sec. 12 Twp. 2 R. 19WWell No. 4 Argan

Phillips

Company

COMPLETE

Contractor


SE/C

E/1.2/61
SECTION PLAT

Ft. from N. Line

330 Ft. from S. Line330 Ft. from E. Line

Ft. from W. Line

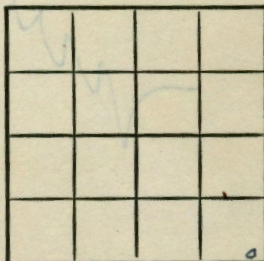

Phillips County

Location

Rig up

Drilling and Remarks:

*Line 8283**5" @ 3354**Permit 84001 +**SW Rd**2700*

Date

NOV 19 1947

19

S. J. LEWIS

Scout

RECORD

Cased in, ft.

Sand

Gas

Oil

Total Depth *13364*

PRODUCTION

1st 24 hrs. Nat.

1st 24 hrs. after shot

Gas Cu. Ft.

Dry Hole

Abandoned

Map No. Sec. 12 Twp. 2 R. 19WWell No. 4 Argan

Phillips

Company

FIRST REPORT

Contractor


SE/C

SECTION PLAT

Ft. from N. Line

330 Ft. from S. Line330 Ft. from E. Line

Ft. from W. Line

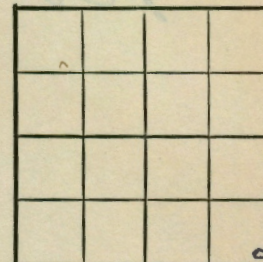

Phillips County

Location

Rig up

Drilling and Remarks:

R U R

Date

AUG 20 1947

19

S. J. LEWIS

Scout

RECORD

Cased in, ft.

Sand

Gas

Oil

Total Depth

PRODUCTION

1st 24 hrs. Nat.

1st 24 hrs. after shot

Gas Cu. Ft.

Dry Hole

Abandoned