


Phillips

KANSAS

Section 12 Township 2 Range 19WWell No. #6 ArganCompany Phillips Pet.

NORTH

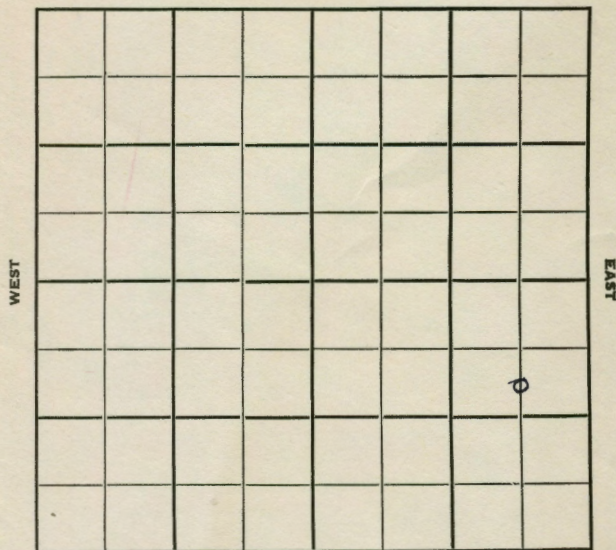

SOUTH

9

Phillips

Sec. 12 Twp. 2 R. 19WWell No. #6 Argan FarmCompany Phillips Pet.Contractor Huffstutter

990 Ft. from N. Line


Ft. from S. Line

660 Ft. from E. Line

Ft. from W. Line

C S/2 NE SE

NORTH

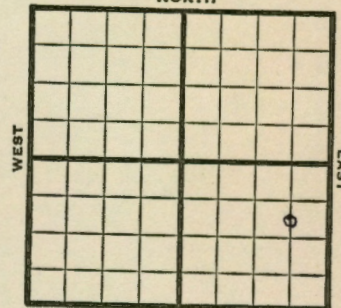

SOUTH

1951

Elev. 2156

REPORT

11/7
1952
1/2

Location

Spud 11-9-51

Oil Well TD 3504

8" @ 527

Heeb. 3252 Tor. 3279

Lans. 3296 B KC 3494

TD 3504 5" @ 3504 CO to 3457

40/ 3440-50 500 A S/ 10 1/2 BO

3/4 BW 10 hr. 1500 A S/ 10 1/2 BO

5 hr. SP 3437 40/3418-28 500 A

S/ 7 1/2 BW SP 3407 48/ 3382-94

B/ 3/4 BO 3/4 BW 1 hr. 32/ 3370-78

B/ 1/2 GO 1 GWPH 500A S/ 3 BO

1/2 BW 7 hr. 1500A S/ 5 BO 5 BW

6 hr. CO to 3457 SP 3360

28/ 3345-52 S/ 2 BOPH

36/ 3372-36 S/ 4 BO 3 hr. 500 A

S/ 28 BO 8 1/2 BW 12 hr. 3000 A

S/ 13 BO 13 BW 5 hr. SP 3315

24/ 3278-84 44/ 3295-3306

S/ 1 BOPH 24hr. 500 A S/ 13


BO 7 BW 200 A S/ 40 BO 26 BW

12 hr. S/ 37 BO 27 BW 7 hr.

Comp. 78 BOPD

COMPLETED

County **Phillips** State **Kansas**
 Sec. **12** (Blk. Twp.) **2** (Sur. Rge.) **19W** Map No.
 Operator **Phillips Pet.**
 Well No. **6** Farm **Argan**
 Elev. _____ Location **C S/2 NE SE**

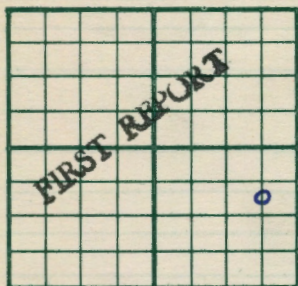


990 Ft. From **N** Line **SE**
660 Ft. From **E** Line Quarter
 Ist. Report **NOV 7 1951**
 Completion _____
 Remarks _____

Spudding Date _____

Drig. Data _____

Huffstutter**Location****J. E. TYRA**

County **Phillips** State **Kansas**
 Sec. **12** (Blk. Twp.) **2** (Sur. Rge.) **19W** Map No.
 Operator **Phillips Pet.**
 Well No. **6** Farm **Argan**
 Elev. **2156** Location **C S L NE SE**

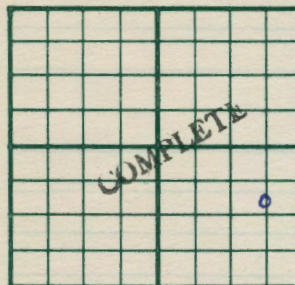

990 Ft. From **N** Line **SE**
660 Ft. From **E** Line Quarter

Ist. Report _____

Completion **JAN 2 1952**Remarks **Huffstutter Pool**Spudding Date **11-9-51**Drig. Data **Oil well TD 3504****8" @ 527 Heeb. 3252 Tor. 3279****Lans. 3296 B KC 3494 TD 3504 5" @ 3504****CO to 3457 40/ 3440-50 500 A S/ 10 1/2 bo****3/4 bw 10 hr. 1500 A S/ 10 1/2 bo 5 hr.****SP 3437 40/ 3418-28 500 A S/ 7 1/2 bw****SP 3407 48/ 3382-94 B/ 3/4 bo 3/4 bw****1 hr. 32/ 3370-78 B/ 1/2 go 1 gwph****500 A S/ 3 bo 1/2 bw 7 hr. 1500 A****S/ 5 bo 5 bw 6 hr. CO to 3457 SP 3360****28/ 3345-52 S/ 2 boph 36/ 3327-36****S/ 4 bo 3 hr. 500 A S/ 28 bo 8 1/2 bw****12 hr. 3000 A S/ 13 bo 13 bw 5 hr.****SP 3315 24/ 3278-84 44/ 3295-3306****S/ 1 boph 2 hr. 500 A S/ 13 bo 7 bw****J. E. TYRA**

Drig. Data

2000 A. S/ 40 bo 26 bw 12 hr. S/ 37 bo
27 bw 7 hr. Comp. 79 bopd

JAN 9 1952

Scout Cards
Land Small Map
Land Wall Map
Tracings
Plans Map
Price Map
Misc.