

KANSAS


Phillips

FORM 51 5M PETROL

Section 12 Township 2 Range 19-W

Well No. #1 A. H. Morgan

Company Magnolia

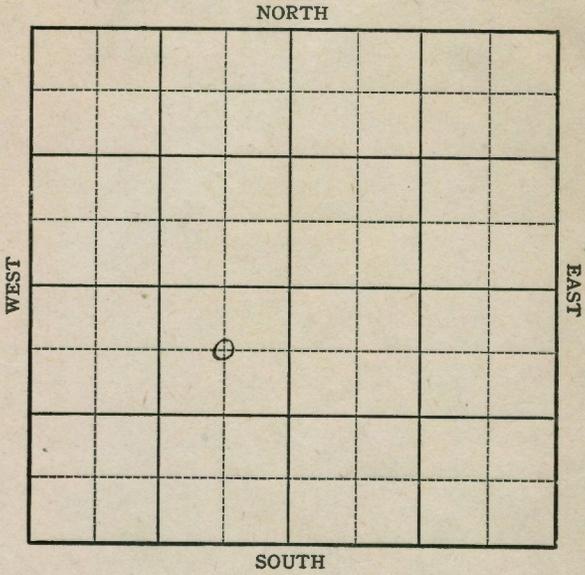

11

FORM 252-A
5M 9-43 GASS

KANSAS

Phillips

Sec. 12 Twp. 2 R. 19-W

Well No. #1 A. H. Morgan Farm

Magnolia Company


660 Ft. from N. Line

_____ Ft. from S. Line

660 Ft. from E. Line

_____ Ft. from W. Line

Elev. 2256

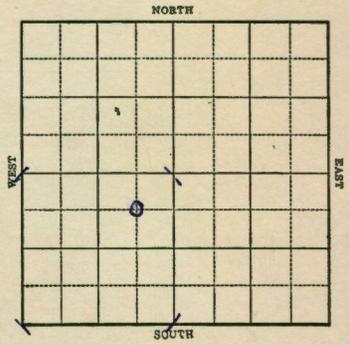

1943

REPORT

11/3 Location
 11/10 10" @ 266'
 WOC
 11/17 Lanc. 3351
 Drlg. 3414
 12/1 5" @ 3422
 Lans 3351
 TD 3460
 6000 acid
 Pump 227 Pot
 Grav. 35.8

COMPLETED

Map No. 38 Sec. 12 Twp. 2 R. 19W

Well No. 1 A. H. Morgan


Magnolia Company

COMPLETED Contractor

C NE SW

SECTION PLAT

660 Ft. from N. Line
Ft. from S. Line
660 Ft. from E. Line
Ft. from W. Line

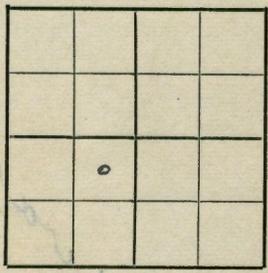

Dayton Pool

Location _____

Rig up _____

Drilling and Remarks:

*Loss 335
5" @ 3422
6000 acid
Pump 227 Prod.
35 1/2 cu*

RECORD

Cased _____ in., _____ ft.
Sand _____
Gas _____
Oil _____
Total Depth 3460

PRODUCTION

1st 24 hrs. Nat. _____
1st 24 hrs. after shot _____
Gas _____ Cu. Ft.
Dry Hole _____
Abandoned _____

Date _____

DEC 1 1943 19

S. J. LEWIS Scout

Map No. 38 Sec. 12 Twp. 2 R. 19W

Well No. 1 A. H. Morgan


Magnolia Company

FIRST REPORT Contractor

C NE SW

SECTION PLAT

660 Ft. from N. Line
Ft. from S. Line
660 Ft. from E. Line
Ft. from W. Line

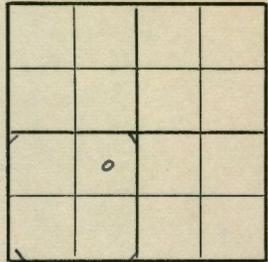

Dayton Pool

Location X

Rig up _____

Drilling and Remarks:

RECORD

Cased _____ in., _____ ft.
Sand _____
Gas _____
Oil _____
Total Depth _____

PRODUCTION

1st 24 hrs. Nat. _____
1st 24 hrs. after shot _____
Gas _____ Cu. Ft.
Dry Hole _____
Abandoned _____

Date _____

NOV 3 1943 19

S. J. LEWIS Scout