


Section 13 Township 2 Range 19W  
 Well No. 2 Culbertson  
 Company Tom Allan etal

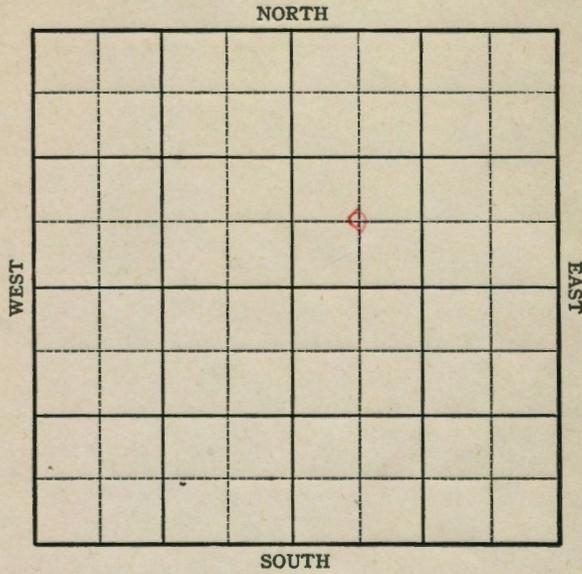

7


Sec. 13 Twp. 2 R. 19-W  
 Well No. #2 Culbertson Farm  
Tom Allan etal Company

\_\_\_\_\_ Ft. from N. Line

660 Ft. from S. Line

\_\_\_\_\_ Ft. from E. Line

660 Ft. from W. Line

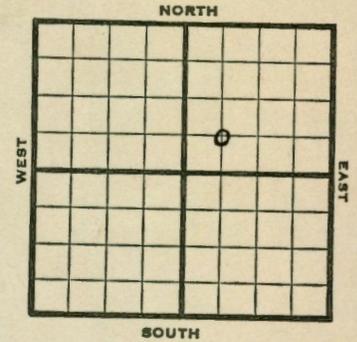

C SW NE

1945

**Elev. 2182**

REPORT

11/21 8" @ 181'  
 Drlg. 2248'  
 11/28 **Lans 3270**  
 TD 3359  
 5" @ 3359' RUST  
 12/5 TD 3382  
 21 shots 3271-3277 2000 acid.  
 26 shots 3291-3297  
 21 shots 3321-3326  
 42 shots 3351-3352 2000 acid.  
 Swb. 3 oil per hr.  
 12/12 " " " " "  
 12/19 **Lans 3270**  
 5" @ 3359  
 Perf. 4000 acid.  
 TD 3359  
 Pump 75 Pot.  
 Grav. 35.8

**COMPLETED**

KANSAS Kansas Pool Name Dayton Pool  
Map No. 138 Sec. 13 Twp. 2 R. 19W

Well No. 2 Culbertson  
Tom Allan et al. Company

COMPLETED

Contractor

C SW NE

SECTION PLAT

Ft. from N. Line  
660 Ft. from S. Line  
Ft. from E. Line  
660 Ft. from W. Line

		0	

Phillips County

Location

Rig up

Drilling and Remarks:

Lane 3270  
570339

Prof.  
4000 acid

Pump 75 Rd  
258 ft

RECORD

Cased in, ft.

Sand

Gas

Oil

Total Depth 8859

PRODUCTION

1st 24 hrs. Nat.

1st 24 hrs. after shot

Gas Cu. Ft.

Dry Hole

Abandoned

Date

DEC 1 9 1945

19

S. J. LEWIS

Scout

FORM 26 200 BKS. 1 44 PETROL KANSAS Kansas Pool Name Dayton  
Map No. 138 Sec. 13 Twp. 2 R. 19W

Well No. 2 Culbertson  
Tom Allan et al. Company

FIRST REPORT

Contractor

C SW NE

SECTION PLAT

Ft. from N. Line  
660 Ft. from S. Line  
Ft. from E. Line  
660 Ft. from W. Line

		0	

Phillips County

Location

Rig up

Drilling and Remarks:

8" @ 181  
2248

RECORD

Cased in, ft.

Sand

Gas

Oil

Total Depth

PRODUCTION

1st 24 hrs. Nat.

1st 24 hrs. after shot

Gas Cu. Ft.

Dry Hole

Abandoned

Date

NOV 21 1945

19

S. J. LEWIS

Scout