


Section 13 Township 2 Range 19W

Well No. #3 Dusin

Company C R A

Dayton Pool

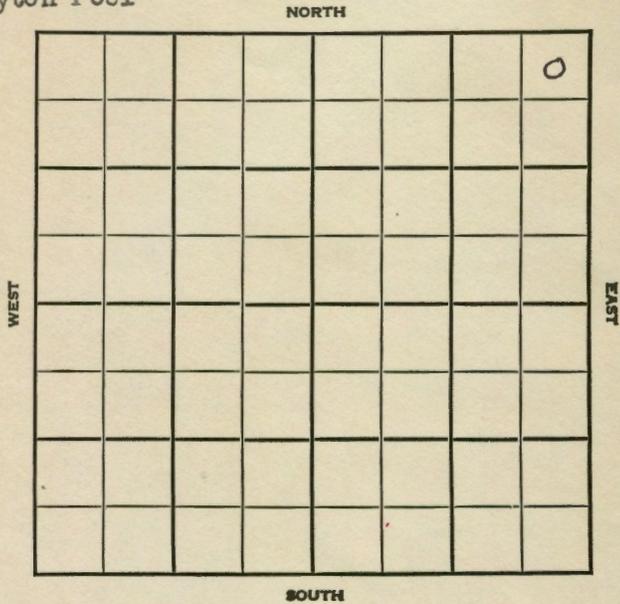

Sec. 13 Twp. 2 R. 19W

Well No. #3 Dusin

C R A

Dayton Pool


330' Ft. from N. Line

Ft. from S. Line

330' Ft. from E. Line

Ft. from W. Line

NE/C

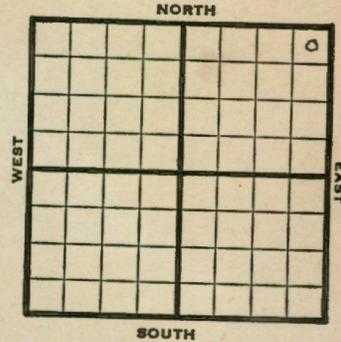

1948 Elev. 2159' REPORT

Date	Location
2/25	Location
3/3	"
3/10	"
3/17	"
3/24	"
3/31	"
4/7	Drlg. 3180'
4/14	Lansing 3251' TD 3326' 5" @ 3323' RUST
4/21	"
4/28	"
5/5	Lans. 3251' 5" @ 3323' 9000 Acid Pump 15 oil Pot. Gr. 27° TD 3357'

COMPLETED

Map No. 138 Sec. 13 Twp. 2 R. 19W

Well No. 3 Dusin

C R A Company

COMPLETE Contractor

NE/C SECTION PLAT

330 Ft. from N. Line

\_\_\_\_\_ Ft. from S. Line

330 Ft. from E. Line

\_\_\_\_\_ Ft. from W. Line


Phillips County

Location \_\_\_\_\_

RECORD

Cased \_\_\_\_\_ in., \_\_\_\_\_ ft.

Rig up \_\_\_\_\_

Sand \_\_\_\_\_

Drilling and Remarks:

Gas \_\_\_\_\_

*Lane 8251*

Oil  \_\_\_\_\_

*5" C 3323*

Total Depth 2725

*2000 acid*

PRODUCTION

*Pump 15 in. 10 ft*

1st 24 hrs. Nat. \_\_\_\_\_

1st 24 hrs. after shot \_\_\_\_\_

Gas \_\_\_\_\_ Cu. Ft.

Dry Hole \_\_\_\_\_

Abandoned \_\_\_\_\_

*2724*

Date

MAY 5 1948 19 S. J. LEWIS Scout

Map No. \_\_\_\_\_ Sec. 13 Twp. 2 R. 19W

Well No. 3 Dusin

C R A Company

FIRST REPORT Contractor

NE/C SECTION PLAT

330 Ft. from N. Line

\_\_\_\_\_ Ft. from S. Line

330 Ft. from E. Line

\_\_\_\_\_ Ft. from W. Line


Phillips County

Location X

RECORD

Cased \_\_\_\_\_ in., \_\_\_\_\_ ft.

Rig up \_\_\_\_\_

Sand \_\_\_\_\_

Drilling and Remarks:

Gas \_\_\_\_\_

Oil \_\_\_\_\_

Total Depth \_\_\_\_\_

PRODUCTION

1st 24 hrs. Nat. \_\_\_\_\_

1st 24 hrs. after shot \_\_\_\_\_

Gas \_\_\_\_\_ Cu. Ft.

Dry Hole \_\_\_\_\_

Abandoned \_\_\_\_\_

Date

FEB 25 1948 19 S. J. LEWIS Scout