


Section 13 Township 2 Range 19W
 Well No. #4 Dusin
 Company C R A
 Dayton Pool

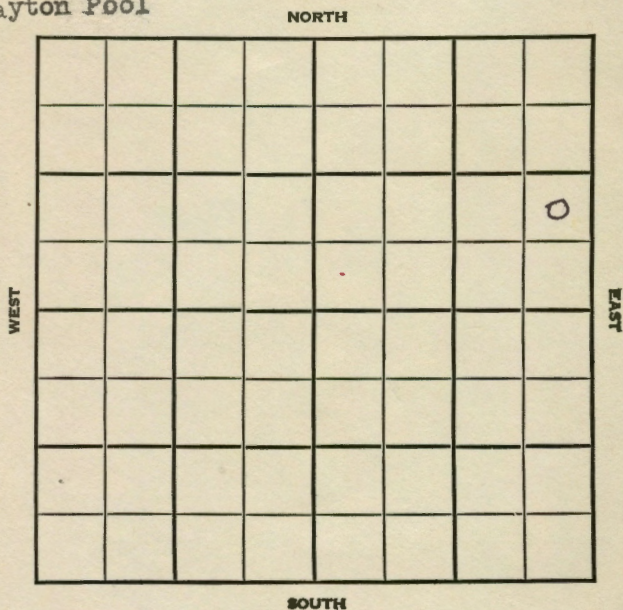


8

Sec. 13 Twp. 2 R. 19W
 Well No. #4 Dusin Farm _____
 Company C R A

Dayton Pool

_____ Ft. from N. Line
 990' _____ Ft. from S. Line
 330' _____ Ft. from E. Line
 _____ Ft. from W. Line
 NE SE NE

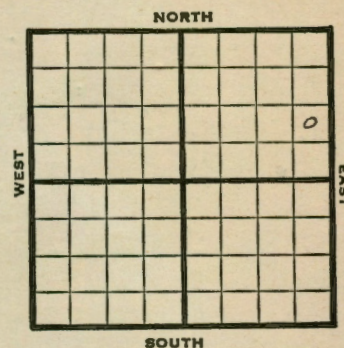

1948 **Elev. 2151' REPORT**

2/25	Location
3/3	"
3/10	"
3/17	"
3/24	"
3/31	"
4/7	"
4/14	8" @ 211' Drlg. 2215'
4/21	Heebner 3218' Lansing 3243' TD 3321' 5" @ 3316' RUST
4/28	"
5/5	"
5/12	Plug 3309- 3 shots 3307-09 23 " 2295-3304 26 " 3266-75 - 6000 acid swb 120 bbls oil 3 hrs.
5/19	Lansing 3248 corrected

OVER

1948

6/1

Lans. 3248'

5" @ 3316'

Perf

Acid 6000

Pump 55 Pot. Oil

Gr. 29°


TD 3348'

COMPLETED

Map No. _____ Sec. 13 Twp. 2 R. 19WWell No. 4 Dusin_____
C R A Company_____
FIRST REPORT Contractor

NE SE NE

SECTION PLAT

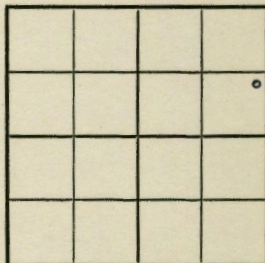Ft. from N. Line990 Ft. from S. Line330 Ft. from E. Line_____
Ft. from W. Line

Phillips County

Location X

Rig up _____

Drilling and Remarks:

RECORD

Cased _____ in., _____ ft.

Sand _____

Gas _____

Oil _____

Total Depth _____

PRODUCTION

1st 24 hrs. Nat. _____

1st 24 hrs. after shot _____

Gas _____ Cu. Ft.

Dry Hole _____

Abandoned _____


Date

FEB 25 1948 19 _____ S. J. LEWIS Scout

Map No. 138 Sec. 13 Twp. 2 R. 19WWell No. 4 Dusin_____
C R A Company_____
COMPLETE Contractor

NE SE NE

SECTION PLAT

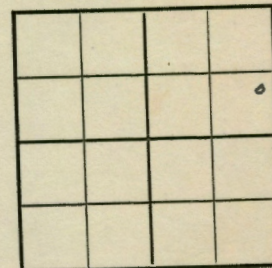Ft. from N. Line990 Ft. from S. Line330 Ft. from E. Line_____
Ft. from W. Line

Phillips County

Location _____

Rig up _____

Drilling and Remarks:


RECORD

Cased _____ in., _____ ft.

Sand _____

Gas _____

Oil ☒Total Depth 8345

PRODUCTION

1st 24 hrs. Nat. _____

1st 24 hrs. after shot _____

Gas _____ Cu. Ft.

Dry Hole _____

Abandoned _____

Date

JUN 1 1948 19 _____ S. J. LEWIS Scout