


KANSAS

Phillips

Section 19 Township 2 Range 19W
 Well No. #1 Brands Est
 Company Mazda Oil

NORTH

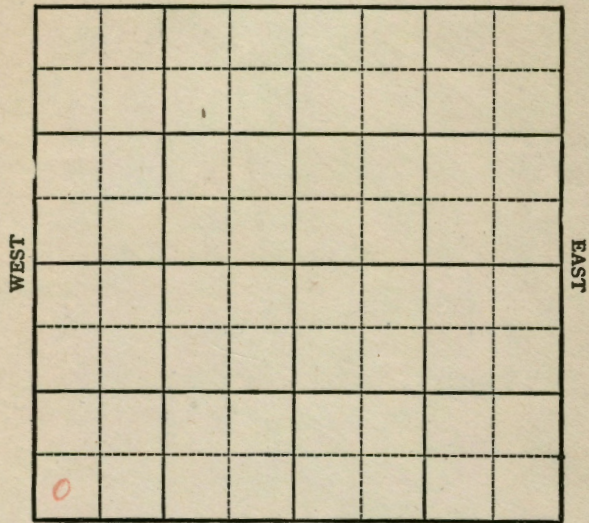

SOUTH

KANSAS

Phillips

Sec. 19 Twp. 2 R. 19W

Well No. #1 Brands Est. Farm
Mazda Oil Company

Wildcat


SW/C

Ft. from N. Line

330' Ft. from S. Line

Ft. from E. Line

330' Ft. from W. Line

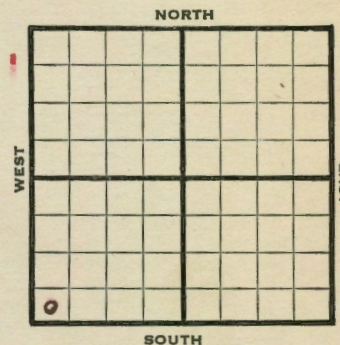

SOUTH

1944

REPORT

6/21 8" @ 263
 Drlg. 740

7/5 **Lans 3491**
Arb. 3850
Granite Wash 4110
TD 4119

ABANDONED

KANSAS
 Pool Name Wildcat
 Map No. 138 Sec. 19 Twp. 2 R. 19W
 Well No. 1 Brands Est.
Mazda Oil Company
ABANDONED Contractor

SW/C

SECTION PLAT

Ft. from N. Line
330 Ft. from S. Line
 Ft. from E. Line
330 Ft. from W. Line

Phillips County

Location

Rig up

Drilling and Remarks:

Line 349/Oil 4-3838Granite block 4118

RECORD

Cased in. ft.
 Sand
 Gas
 Oil
 Total Depth 4119

PRODUCTION

1st 24 hrs. Nat.
 1st 24 hrs. after shot
 Gas Cu. Ft.
 Dry Hole
 Abandoned

Date

JUL 5 1944 19

S. J. LEWIS Scout

KANSAS
 Pool Name Wildcat
 Map No. 138 Sec. 19 Twp. 2 R. 19W
 Well No. 1 Brands Est.
Mazda Oil Company
FIRST REPORT Contractor

SW/C

SECTION PLAT

Ft. from N. Line
330 Ft. from S. Line
 Ft. from E. Line
330 Ft. from W. Line

Phillips

Location

Rig up

Drilling and Remarks:

8" - 263Drlg. 740

RECORD

Cased in. ft.
 Sand
 Gas
 Oil
 Total Depth

PRODUCTION

1st 24 hrs. Nat.
 1st 24 hrs. after shot
 Gas Cu. Ft.
 Dry Hole
 Abandoned

Date

JUN 21 1944 19

S. J. LEWIS Scout