


**KANSAS**

Section 23 Township 2 Range 19W

Well No. #1 Hooper est.

Company Lewis Drilling Co.

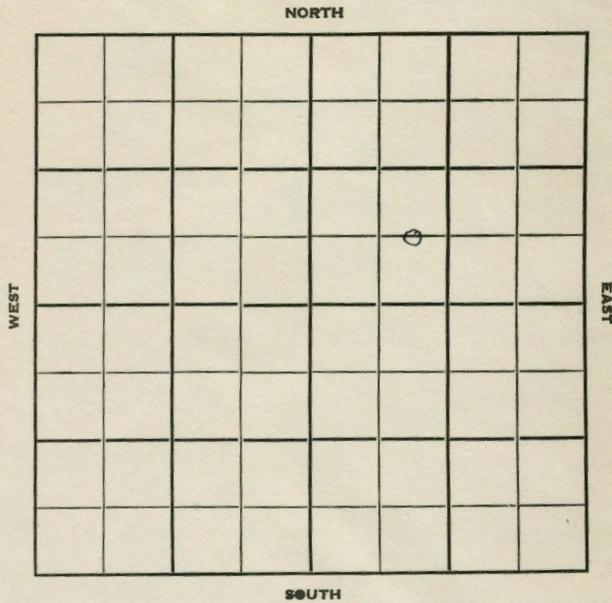

7

Phillips

**KANSAS**

Sec. 23 Twp. 2 R. 19W

Well No. #1 Hopper Est. Farm

Lewis Drlg. Co. Company

Lewis Drlg. Co. - Contr. Contractor  
Huffstutter


         Ft. from N. Line

660' Ft. from S. Line

         Ft. from E. Line

990' Ft. from W. Line

C E/2 SW NE

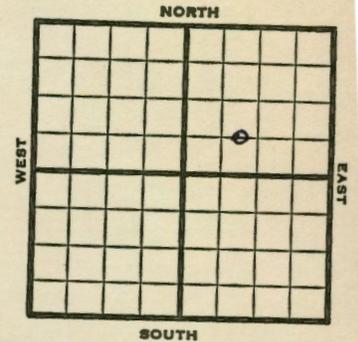

1951 **Elev. 2156'** REPORT

10/17 Spud 10-12-51  
8" @ 165  
Drlg. 2650

1952  
2/6 **Heeb. 3238 Lans. 3264**  
TD 3475 5" @ 3475 S/5 BOPH

2/13 No report

2/20 Spud 10-12-51  
Oil Well TD 3575  
8" @ 165 **Heeb. 3238**  
**Lans. 3264** TD 3475  
DST? 3475 opn 1 hr  
Rec. 50' ocm 5" @ 3475'  
19/3464-70 500 A S/5½ boph  
Comp. 200 bopd

**COMPLETED**

County Phillips State Kansas  
 Sec. 23 (Blk. 2 (Sur. 19W Map No.  
 Operator Lewis Drlg.  
 Well No. 1 Farm Hopper Est.  
 Elev. 2156 Location C E L SW NE


660 Ft. From S Line NE  
 990 Ft. From W Line Quarter

1st. Report  
 Completion FEB 20 1952

Remarks Huffstutter Pool  
Lewis Drlg. - Contr.

Spudding Date 10-12-51

Drlg. Data Oil well TD 3475  
8" @ 165 Heeb. 3238 Lans. 3264  
TD 3475 DST ? - 3475 open 1 hr.  
Rec. 50' ocm 5" @ 3475 19/ 3464-70  
500 A S/ 5 1/2 boph Comp. 200 bopd

J. G. McGEHEE

County Phillips State Kansas  
 Sec. 23 (Blk. 2 (Sur. 19W Map No.  
 Operator Lewis Drilling Co.  
 Well No. 1 Farm Hopper est.  
 Elev. Location C E/2 SW NE


660 Ft. From S Line NE  
 990 Ft. From W Line Quarter

1st. Report OCT 17 1951

Completion

Remarks Lewis Drlg. - Contr.

Spudding Date 10-12-51

Drlg. Data Huffstutter  
8" @ 165 Drlg. 2650

J. E. TYRA