


Section 23 Township 2 Range 19WWell No. #2 HeffronCompany Lewis Drlg.

NORTH

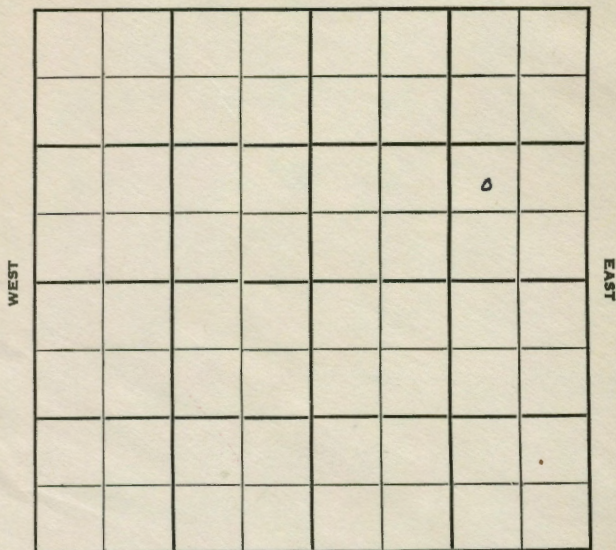

SOUTH

8

Sec. 23 Twp. 2 R. 19WWell No. #2 Heffron

Farm

Lewis Drlg.

Company

Contractor

Ft. from N. Line

990

Ft. from S. Line


990

Ft. from E. Line

Ft. from W. Line

NW SE NE

NORTH

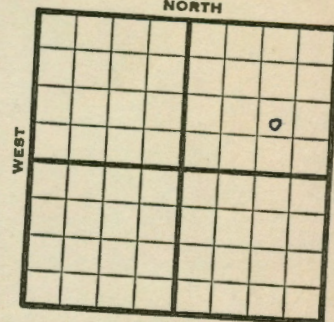

SOUTH

1952

Elev. 2215' REPORT

1/2

Spud 12-19-51

8" @ 217'

Drlg. 2280'

2/6

Heeb. 3295 KC 3320 TD 3540

5" @ 3540 40/ 3487-96

Test 2 gal oph 1500 A

2/13

Test 3 BOPH for 4 hrs. PB 3450

24/3409-15, test 10 gal opd

1500 A Test 15 BOPH for 3 hrs.

& trace wtr POP

2/19

Spud 12-19-51

Oil Well TD 3540

8" @ 217'

Heeb. 3295 KC 3320

DST 3402-25 opn 1 hr. Rec. 45' hocom

45' mud & oil TD 3540 5" @ 3540

24/3384-90 24/3364-70 24/3301-07


DC to 3515 40/3487-96 2 goph 1500 A

3 boph 4 hrs PB 3450 24/3409-15

10 goph 1500 A 15 boph 3 hrs.

Comp. 223 bopd

COMPLETED

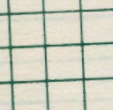

J. G. McGEHEE

0

FIRST REPORT

J. E. TYRA