


Section 23 Township 2 Range 19 W

Well No. # 2 Kelly

Company Lewis Drlg.

NORTH

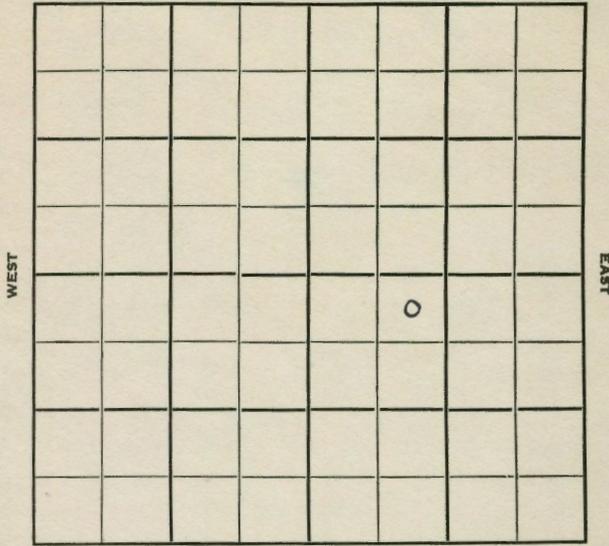

SOUTH

10

Sec. 23 Twp. 2 R. 19W

Well No. #2 Kelly Farm

Lewis Drlg. Company

Lewis Drlg. Contractor

Huffstutter Pool

330 Ft. from N. Line


\_\_\_\_\_ Ft. from S. Line

\_\_\_\_\_ Ft. from E. Line

990 Ft. from W. Line

NE NW SE

NORTH

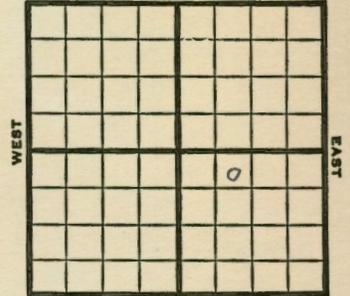

SOUTH

1951

**Elev. 2167'** REPORT

10/3

Spud 9-30-51  
8" @ 190'  
Drlg. 1500'

1952

2/6

**Heeb. 3251 KC 3277** TD 3480  
5" @ 3480 1500 A S/ 2 BOPH POP

2/13

No report

2/20

Spud 9-30-51  
Oil Well TD 3480  
8" @ 190 **Heeb. 3251 KC 3277**  
DST 3288-3300 opn 1 hr. Rec. 20' soc  
DST 3565-80 opn 1 hr. rec 70' ocm  
TD 3480 5" @ 3480 48/3447-58  
B/3 boph 1000 A No inc. 4500 A  
½ boph PB 3390 16/3360-70 B/7 gw  
1 goph 32/3366-79 B/3 gw 1 goph  
1000 A S/5 bw ½ boph PB 3290  
12/3281-85 26 go 3 gwph 1000 A  
S/2 bo 9 bw 12 hrs. 32/3281-85  
1 boph 1500 A S/2 boph Comp. 53 bopd

**COMPLETED**

