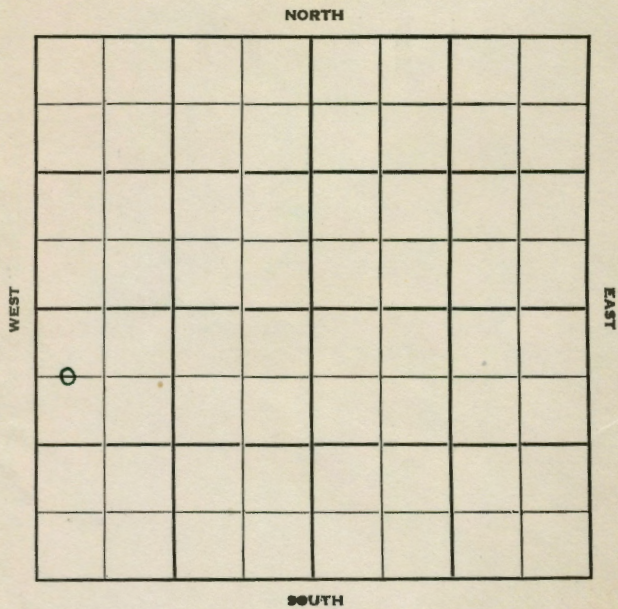


Section 24 Township 2 Range 19WWell No. #1 WeinnanCompany Lewis Drlg.

12

Section 24 Twp. 2 R. 19WWell No. #1 Weinnan

Farm

Lewis Drlg.

Company

Lewis Contr.
Huffstutter

Contractor


660' Ft. from N. Line

Ft. from S. Line

Ft. from E. Line

330' Ft. from W. Line

C W/2 NW SW

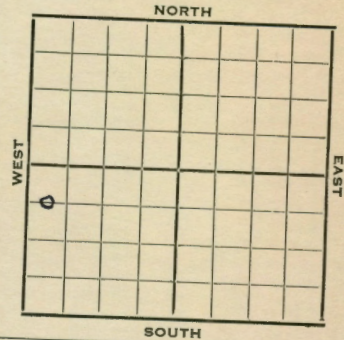


1951 Elev. 2192' REPORT

11/28 Spud 11-22-51
8" @ 185'
Drlg. 2885'1952
1/16

Spud 11-22-51
D&A TD 3530'
8" @ 185'
HEEB 3283 **Lans. 3308**
TD 3530 5" @ 3530
DST 3408 Rec. 10' OCM
DST 3281-3320 rec. 11' OCM
CO to 3502 24/ 3479-85 500 A
6 GO 4 GWPH PB 3430 24/ 3400-06
500 A 3 GO 7 GWPH
D&A

ABANDONED

County Phillips State Kansas
 Sec. 24 (Blk. Twp.) 2 (Sur. Rge.) 19W Map No.
 Operator Lewis Drlg.
 Well No. 1 Farm Weinman
 Elev. 2192 Location C W L NW SW

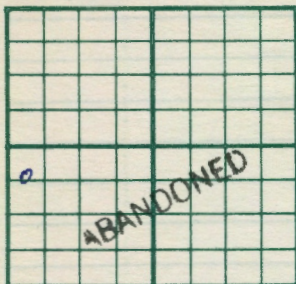

660 Ft. From N Line SW
330 Ft. From W Line Quarter
 1st. Report
 Completion JAN 16 1952
 Remarks Huffstutter Pool
Lewis Drlg. - Contr.
 Spudding Date 11-22-51

Drlg. Data D & A TD 3530
8" @ 185 Heeb. 3283 Lans. 3308
TD 3530 5" @ 3530 DST 3408 Rec/ 10'
ocm DST 3281-3320 Rec. 11' ocm
CO to 3502 24/ 3479-85 500 A
6 go 4 gwph PB 3430 24/ 3400-06
500 A 3 go 7 gwph

D & A

J. E. TYRA

County Phillips State Kansas
 Sec. 24 (Blk. Twp.) 2 (Sur. Rge.) 19W Map No.
 Operator Lewis Drlg.
 Well No. 1 Farm Weinman
 Elev. Location C W/2 NW SW



660 Ft. From N Line SW
330 Ft. From W Line Quarter
 1st. Report Nov 28 1951
 Completion
 Remarks
Lewis - Contr.
 Spudding Date 11-22-51

Drlg. Data Huffstutter
8" @ 185 Drlg. 2885

J. E. TYRA