


KANSAS

Phillips

FORM 51 5M 10-41 PETROL

Section 25 Township 2 Range 19-WWell No. #1 KaiserCompany Tom Allan et al
Dayton Pool

NORTH

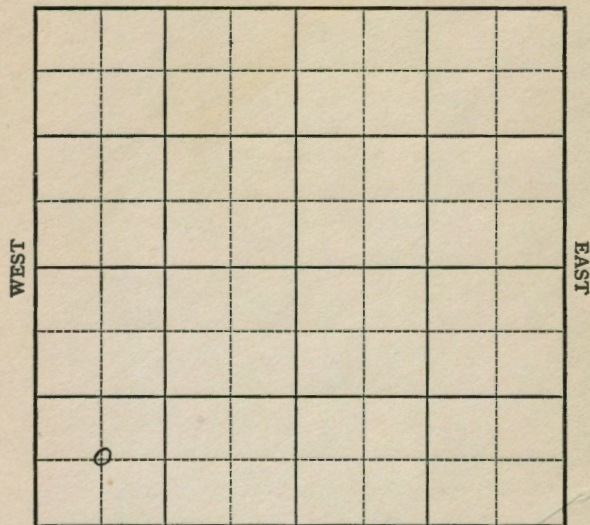

SOUTH

EAST

13

Form 252-A
5M 5-42 Petrol

KANSAS

Phillips


Sec. 25 Twp. 2 R. 19-WWell No. #1 Kaiser FarmTom Allan et al Company

(Dayton Pool)

Ft. from N. Line

660 Ft. from S. Line

Ft. from E. Line

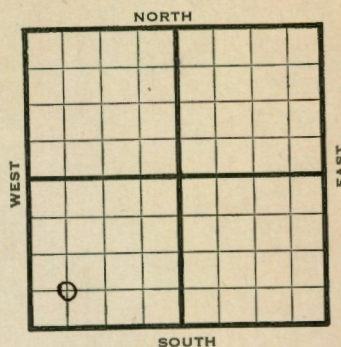660 Ft. from W. LineElev. 2148

WEST

EAST

SOUTH

1942

REPORT

8/5	Location
8/12	"
8/19	8" - 65' Anhy 1598' Drlg. 2470'
8/27	TD 2605 SD for repairs
9/2	Lans. 3220 5" - 3242 T.D. RUST.
9/9	SD 3294-96, 3316-18, 3333-35, TD 3346 1500-Acid swab 3 oil per hr.
9/16	4000 acid swab 6 oil per hr. 48 shots 3221-28-3240-47
9/23	" "
9/30	TD 3346' Putting on pump.
10/7	" " " "
10/14	" " " "
10/21	TD 3346 Putting on pump
10/29	" "
11/4	" "
11/11	" "
11/18	" "
11/24	" "

OVER

1942

12/2 TD 3345 putting on pump

12/9 " " "

12/16 " " "

12/22 " " "

12/29 " " "

1943

1/6 " " "

1/13 " " "

1/20 TD 3440 swab 15 oil per hour.

1/27 " " " " " " "

2/3 " " " " " " "

2/10 " " " " " " "

2/17

Lans 3220

5" @ 3292'

48 shots 3221-28

T.D. 3346'

5500 gal. acid.

Pump 300 Pot.

Gravity 35.8

COMPLETED

KANSAS

Phillips

Map No. 138 Sec. 25 Twp. 2 R. 19WWell No. 1 Kaiser

Tom Allan et al.

Company

COMPLETED

Contractor

C SW SW

SECTION PLAT

Ft. from N. Line

660 Ft. from S. Line

Ft. from E. Line

660 Ft. from W. Line

DAYTON POOL

Location

RECORD

Cased in, ft.

Sand

Gas

Oil

Total Depth 2346

PRODUCTION

1st 24 hrs. Nat.

1st 24 hrs. after shot

Gas Cu. Ft.

Dry Hole

Abandoned

Date

FEB 17 1943

19

S. J. LEWIS

Scout

KANSAS

Phillips

Map No. 138 Sec. 25 Twp. 2 R. 19WWell No. 1 Kaiser

Tom Allan et al.

Company

FIRST REPORT

Contractor

C SW SW

SECTION PLAT

Ft. from N. Line

660 Ft. from S. Line

Ft. from E. Line

660 Ft. from W. Line

DAYTON POOL

Location XXX

RECORD

Cased in, ft.

Sand

Gas

Oil

Total Depth

PRODUCTION

1st 24 hrs. Nat.

1st 24 hrs. after shot

Gas Cu. Ft.

Dry Hole

Abandoned

Date

AUG 5 1942

19

S. J. LEWIS

Scout