

KANSAS


FORM 51 5M 10-41 PETROL

Phillips

Section 25 Township 2 Range 19-WWell No. #2 KaiserCompany Allan etal

Dayton Pool

NORTH

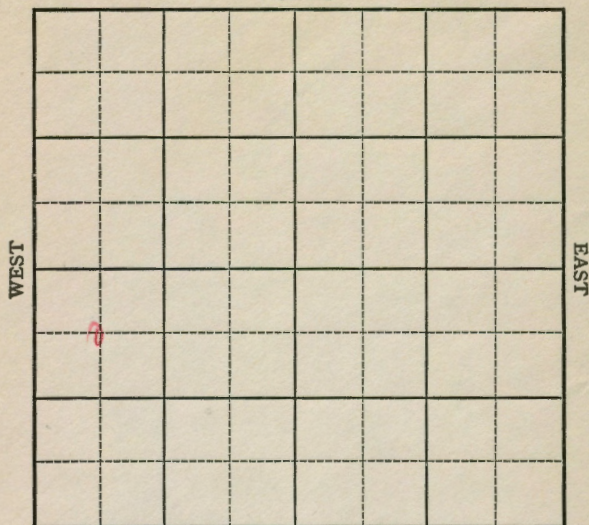

SOUTH

12

Form 252-A
5M 5-42 Petrol

KANSAS


Sec. 25 Twp. 2 R. 19-WWell No. #2 Kaiser FarmAllan etal Company

Dayton pool

Ft. from N. Line

1880 Ft. from S. Line

Ft. from E. Line

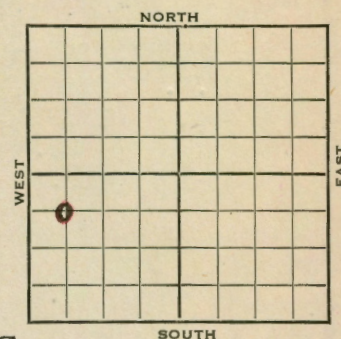580 Ft. from W. LineC NW SW Elw. 2177

1942

REPORT

9/23

Rotary.

9/30

TD 3338 WOC. 5" - 3338

Topeka 3024, Lans. 3248 KC 3298

10/7

TD 3440 swab 15 oil per hr.

10/14

" " "

10/21

TD 3440 swab 15 oil per hr.

10/29

" "

11/4

" "

11/11

" "

11/18

" "

11/24

" "

12/2

" "

12/9

" "

12/16

" "

12/22

" " 4 bbls. oil per hr.

12/29

" "

1943

1/6

" "

1/13

" "

1/20

" "

1/27

" "

OVER

1943

2/3 TD 3440' 4 bbls oil per hr.

2/10 " " "

2/17 **Lans 3224**

5" @ 3336'

T.D. 3440'

8000 gal acid

Pump 75 pot.

Gravity 35.8

COMPLETED

KANSAS

Phillips

Map No. 138 Sec. 25 Twp. 2 R. 19WWell No. 2 Kaiser

Allan et al.

Company

COMPLETED

Contractor

C NW SW

SECTION PLAT

Ft. from N. Line

1880 Ft. from S. Line

Ft. from E. Line

580 Ft. from W. Line

DAYTON POOL

Location

Rig up

Drilling and Remarks:

*lane 3224**5" C 3336**8000 Acid**Pump 75 P.S.D.**35-54*

RECORD

Cased in. ft.

Sand

Gas

Oil

Total Depth 3440

PRODUCTION

1st 24 hrs. Nat.

1st 24 hrs. after shot

Gas Cu. Ft.

Dry Hole

Abandoned

Date

FEB 17 1943

19

S. J. LEWIS

Scout

Phillips

KANSAS

Map No. 138 Sec. 25 Twp. 2 R. 19WWell No. 2 Kaiser

Allan et al.

Company

FIRST REPORT

Contractor

C NW SW

SECTION PLAT

Ft. from N. Line

1880 Ft. from S. Line

Ft. from E. Line

580 Ft. from W. Line

DAYTON POOL

Location

Rig up

Drilling and Remarks:

Rotary

RECORD

Cased in. ft.

Sand

Gas

Oil

Total Depth

PRODUCTION

1st 24 hrs. Nat.

1st 24 hrs. after shot

Gas Cu. Ft.

Dry Hole

Abandoned

Date

FEB 16 1942

19

S. J. LEWIS

Scout

Check spot & feet measurements

Map No. 138 R D Schumaker
Well No. 2 Kalsen

Company Aljan et al.
Contractor FIRST REPORT

SECTION PLAT

C NW 3 W

Feet from N. Line 1880
Feet from S. Line 580
Feet from E. Line 580
Feet from W. Line 580

DAYTON POOL

Location
Rise up
Drilling and Remarks:

RECORD

Cased
Sand
Gas

Misc. Small Maps
Cards
Tracing
France Map
Scarborough Map
Moody Map
Geological Dept.
Moody Flat Book

Date SEP 16 1942